

WATER SYSTEMS CHARACTERISTICS

SUPPLY LINE TO BE FEED WITH A 10 HORSEPOWER PUMP SET TO MAINTAIN A MINIMUM OF 25 P.S.I. TO THE RESIDENCES

FIRE HYDRANTS:

WEST HYDRANT
4 INCH SUPPLY LINE OFF 6 INCH DISTRIBUTION LINE:
500 G.P.M. DRAFT @ -28.7 P.S.I. RESIDUAL
200 G.P.M. FLOW @ 27.8 P.S.I. RESIDUAL
0 G.P.M. FLOW @ 38.1 P.S.I. RESIDUAL

EAST HYDRANT
4 INCH SUPPLY LINE OFF 6 INCH DISTRIBUTION LINE:
500 G.P.M. DRAFT @ -41.5 P.S.I. RESIDUAL
200 G.P.M. FLOW @ 25.6 P.S.I. RESIDUAL
0 G.P.M. FLOW @ 38.05 P.S.I. RESIDUAL

DOMESTIC SERVICES:

2 INCH SERVICE SUPPLY LINES FROM 6 INCH DISTRIBUTION LINE:

REMAINDER PARCEL, @ ELEVATION 222 FT:
SERVICE PROVIDED BY OWN WELL

PARCEL A @ ELEVATION 224 FT:
50 G.P.M. FLOW @ 31.5 P.S.I. RESIDUAL
0 G.P.M. FLOW @ 39.8 P.S.I. RESIDUAL

PARCEL B @ ELEVATION 225 FT:
50 G.P.M. FLOW @ 30.8 P.S.I. RESIDUAL
0 G.P.M. FLOW @ 39.4 P.S.I. RESIDUAL

PARCEL C @ ELEVATION 226 FT:
50 G.P.M. FLOW @ 30.2 P.S.I. RESIDUAL
0 G.P.M. FLOW @ 38.9 P.S.I. RESIDUAL

PARCEL D @ ELEVATION 235 FT:
50 G.P.M. FLOW @ 25.7 P.S.I. RESIDUAL
0 G.P.M. FLOW @ 35.0 P.S.I. RESIDUAL

WELL:
12 G.P.M. FLOW AGAINST 11.0 P.S.I. AT THE WELL HEAD
(MINIMUM FLOW REQUIRED)


STATIC SYSTEM PRESSURES ARE COMPUTED WITH TANKS 90% FULL AND NO ACTIVITY IN SYSTEM.

DYNAMIC RESIDENTIAL SYSTEM PRESSURES ARE COMPUTED WITH ALL SERVICE LINES FLOWING AS INDICATED AT THE SAME TIME.


DYNAMIC WELL PRESSURE IS COMPUTED WITH SYSTEM STILL EXCEPT FOR WELL.

ELEVATIONS NOTED ARE EXISTING GRADE AT HYDRANT OR METER BOX INDICATED. ACTUAL PRESSURE AT RESIDENCE(S) WILL LIKELY BE HIGHER DUE TO DROP IN ELEVATION.

SYSTEM CHARACTERISTICS GIVEN TO THE LEFT WERE THAT DETERMINED DURING DESIGN. ACTUAL PUMPS INSTALLED ARE A 15 HP AND A 2 HP. THESE PUMPS WERE SELECTED TO MEET THE FIRE DEPARTMENT REQUIREMENTS WHICH CHANGED AFTER PERMIT ISSUANCE. THE CURRENT REQUIREMENT DICTATES A DISCHARGE OF 500 GALLONS OR MORE FROM THE LAST HYDRANT WITH A RESIDUAL PRESSURE OF NO LESS THAN 20 P.S.I.. THE 2 H.P. IS SET TO TURN ON AT 40 P.S.I. AND THE 15 H.P. IS SET TO TURN ON AT 30 P.S.I. WITH BOTH SET TO TURN OFF AT 60 P.S.I..

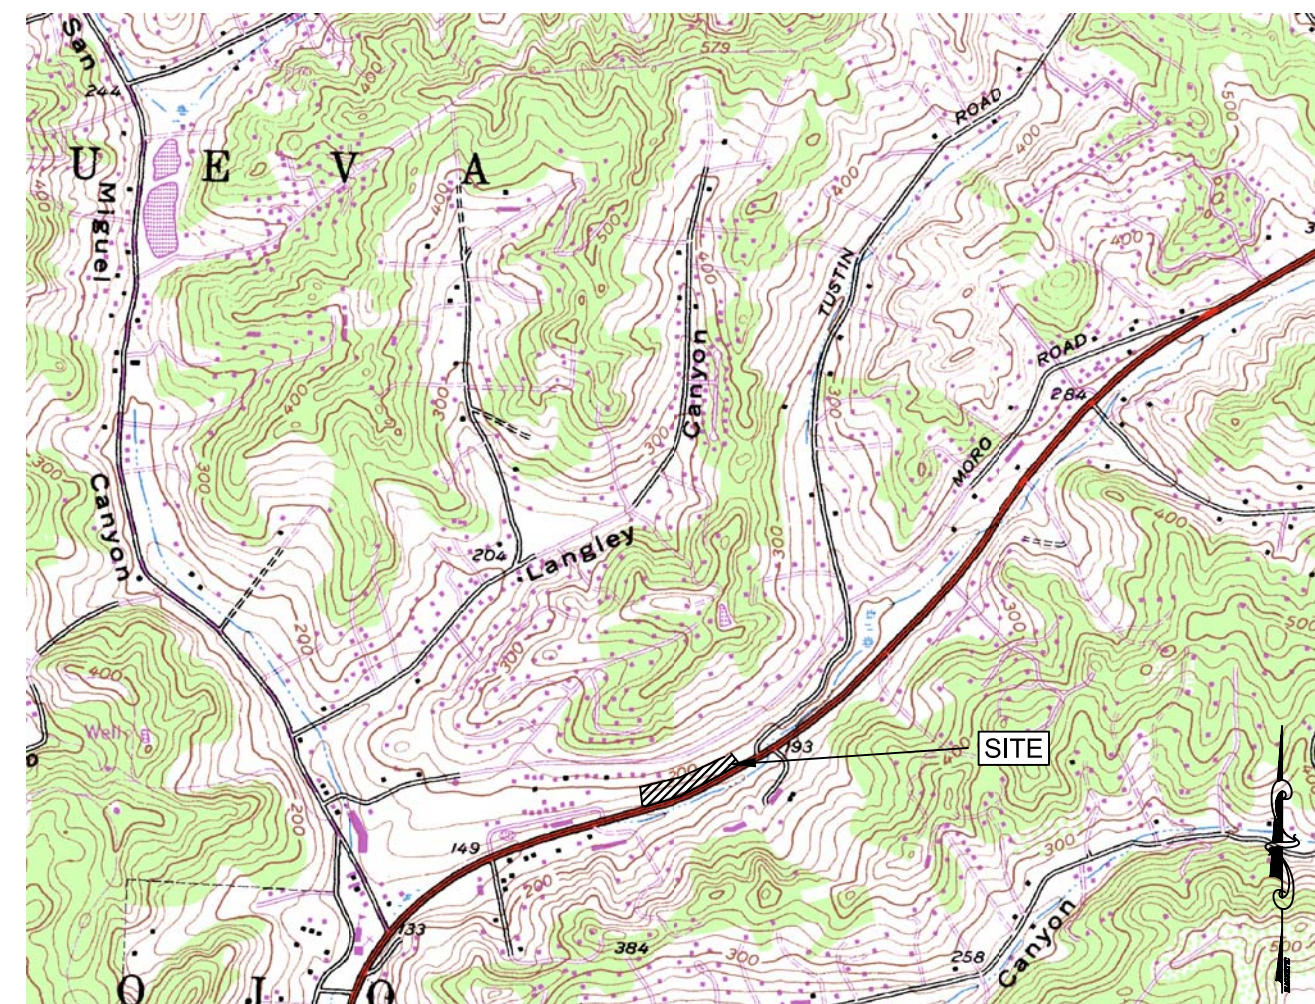

SITE LOCATION, NO SCALE

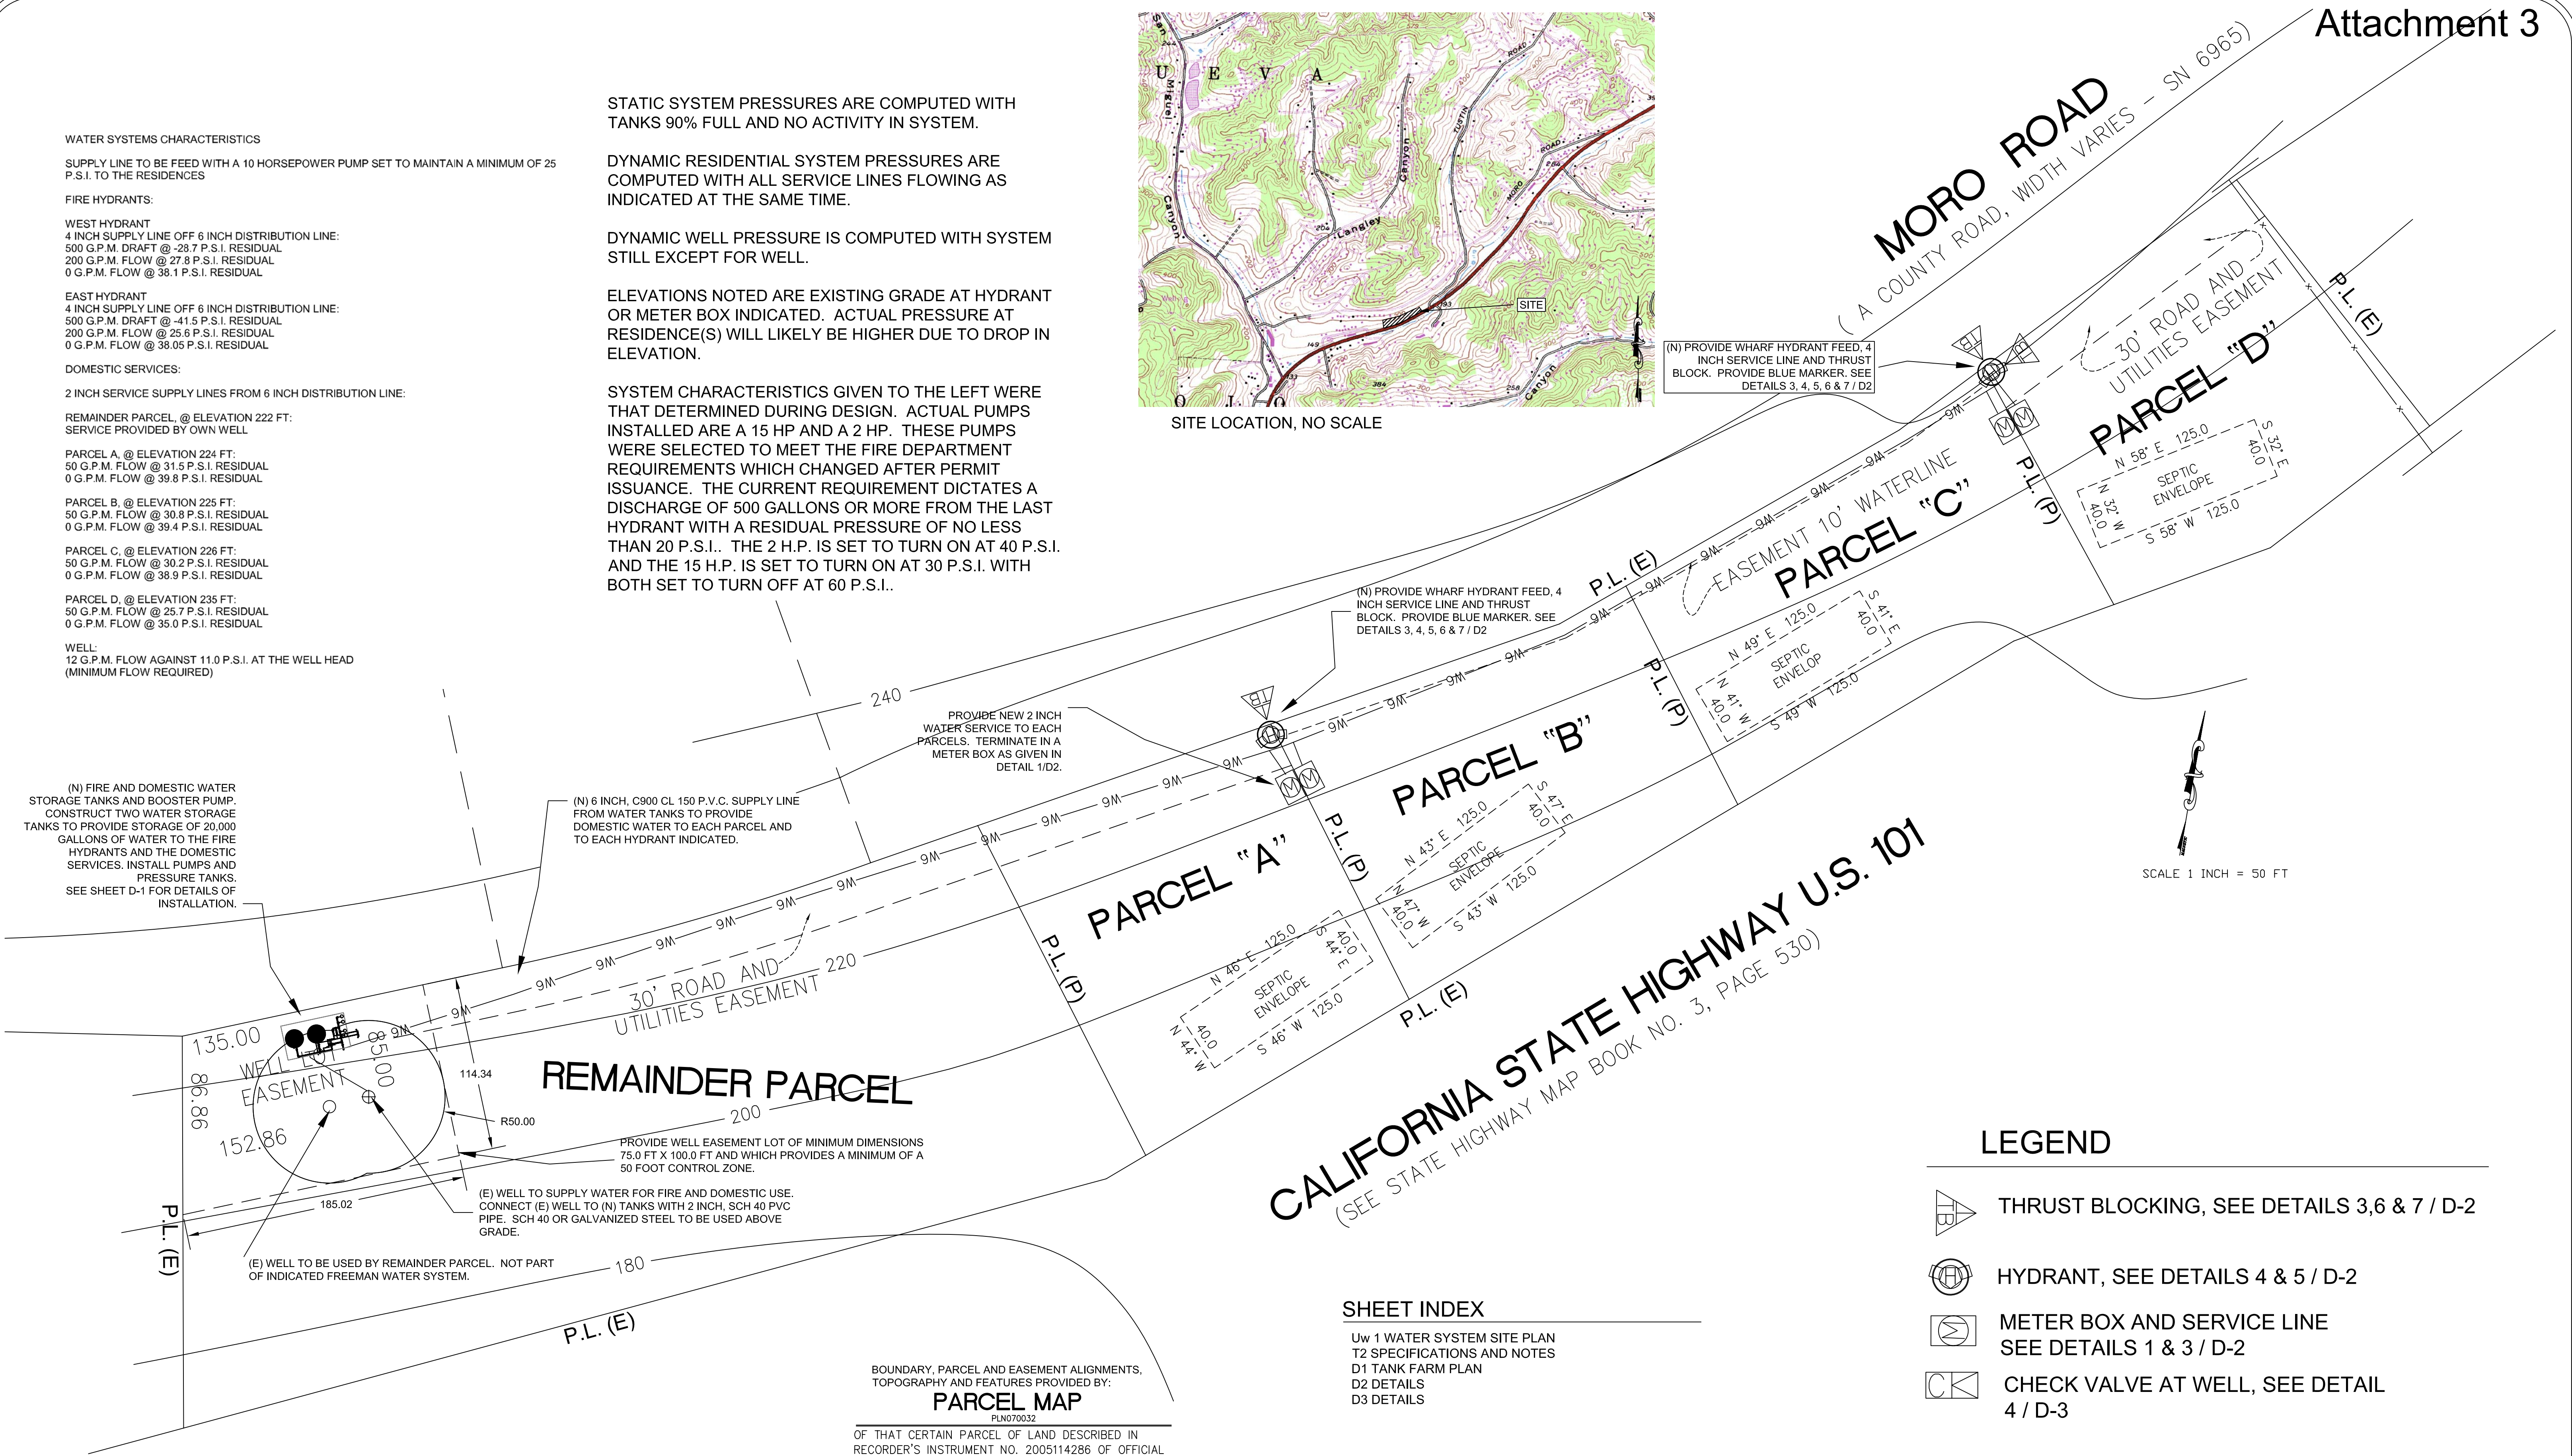

(N) PROVIDE WHARF HYDRANT FEED, 4 INCH SERVICE LINE AND THRUST BLOCK. PROVIDE BLUE MARKER. SEE DETAILS 3, 4, 5, 6 & 7 / D2

(N) PROVIDE WHARF HYDRANT FEED, 4 INCH SERVICE LINE AND THRUST BLOCK. PROVIDE BLUE MARKER. SEE DETAILS 3, 4, 5, 6 & 7 / D2

PROVIDE NEW 2 INCH WATER SERVICE TO EACH PARCELS. TERMINATE IN A METER BOX AS GIVEN IN DETAIL 1/D2.

(N) 6 INCH, C900 CL 150 P.V.C. SUPPLY LINE FROM WATER TANKS TO PROVIDE DOMESTIC WATER TO EACH PARCEL AND TO EACH HYDRANT INDICATED.

(N) FIRE AND DOMESTIC WATER STORAGE TANKS AND BOOSTER PUMP. CONSTRUCT TWO WATER STORAGE TANKS TO PROVIDE STORAGE OF 20,000 GALLONS OF WATER TO THE FIRE HYDRANTS AND THE DOMESTIC SERVICES. INSTALL PUMPS AND PRESSURE TANKS. SEE SHEET D-1 FOR DETAILS OF INSTALLATION.

PROVIDE WELL EASEMENT LOT OF MINIMUM DIMENSIONS 75.0 FT X 100.0 FT AND WHICH PROVIDES A MINIMUM OF A 50 FOOT CONTROL ZONE.

(E) WELL TO SUPPLY WATER FOR FIRE AND DOMESTIC USE. CONNECT (E) WELL TO (N) TANKS WITH 2 INCH, SCH 40 PVC PIPE. SCH 40 OR GALVANIZED STEEL TO BE USED ABOVE GRADE.

(E) WELL TO BE USED BY REMAINDER PARCEL. NOT PART OF INDICATED FREEMAN WATER SYSTEM.

SCALE 1 INCH = 50 FT

LEGEND

- THRUST BLOCKING, SEE DETAILS 3,6 & 7 / D-2
- HYDRANT, SEE DETAILS 4 & 5 / D-2
- METER BOX AND SERVICE LINE SEE DETAILS 1 & 3 / D-2
- CHECK VALVE AT WELL, SEE DETAIL 4 / D-3

SHEET INDEX

- Uw 1 WATER SYSTEM SITE PLAN
- T2 SPECIFICATIONS AND NOTES
- D1 TANK FARM PLAN
- D2 DETAILS
- D3 DETAILS

BOUNDARY, PARCEL AND EASEMENT ALIGNMENTS, TOPOGRAPHY AND FEATURES PROVIDED BY:
PARCEL MAP
PLN070032
OF THAT CERTAIN PARCEL OF LAND DESCRIBED IN RECORDER'S INSTRUMENT NO. 2005114286 OF OFFICIAL RECORDS, IN RANCHO BOLSA NUEVA Y MORO COJO, MONTEREY COUNTY, CALIFORNIA

PREPARED FOR
DAVID H. FREEMAN
APR 125-211-001-000 JOB NO. 25-00
JUNE 2009 SHEET TWO OF TWO

GLS GOETZ LAND SURVEYORS
1318 AUBURN ST (831)424-4114
SALINAS, CALIFORNIA 93901

NOT VALID WITHOUT STAMP AND SIGNATURE



LAWRENCE E. GRICE, P.E.; R.C.E. 66857

GRICE ENGINEERING INC
ENGINEERING • GEOTECHNICS • HYDROLOGY • SOILS • FOUNDATIONS • EARTH STRUCTURES
561A Brunken Avenue Salinas, California Salinas: (831) 422-9619 Monterey: (831) 375-1198 FAX: (831) 422-1896


prepared for
MR. DAVID H. FREEMAN
2628 EL CAMINO REAL NORTH
SALINAS, CALIFORNIA
93907

RESIDENTIAL SUBDIVISION IMPROVEMENT PLAN
WATER SYSTEM PLAN - DOMESTIC AND FIRE
FREEMAN SUBDIVISION, 9999 MORO ROAD, SALINAS, CALIFORNIA; A.P.N. 125-211-001
AS BUILT - WATER SYSTEM SITE PLAN


Date Plotted: Dec 03, 2010

Uw 1

FREEMAN SUBDIVISION
FILE NO. 4988-07.04

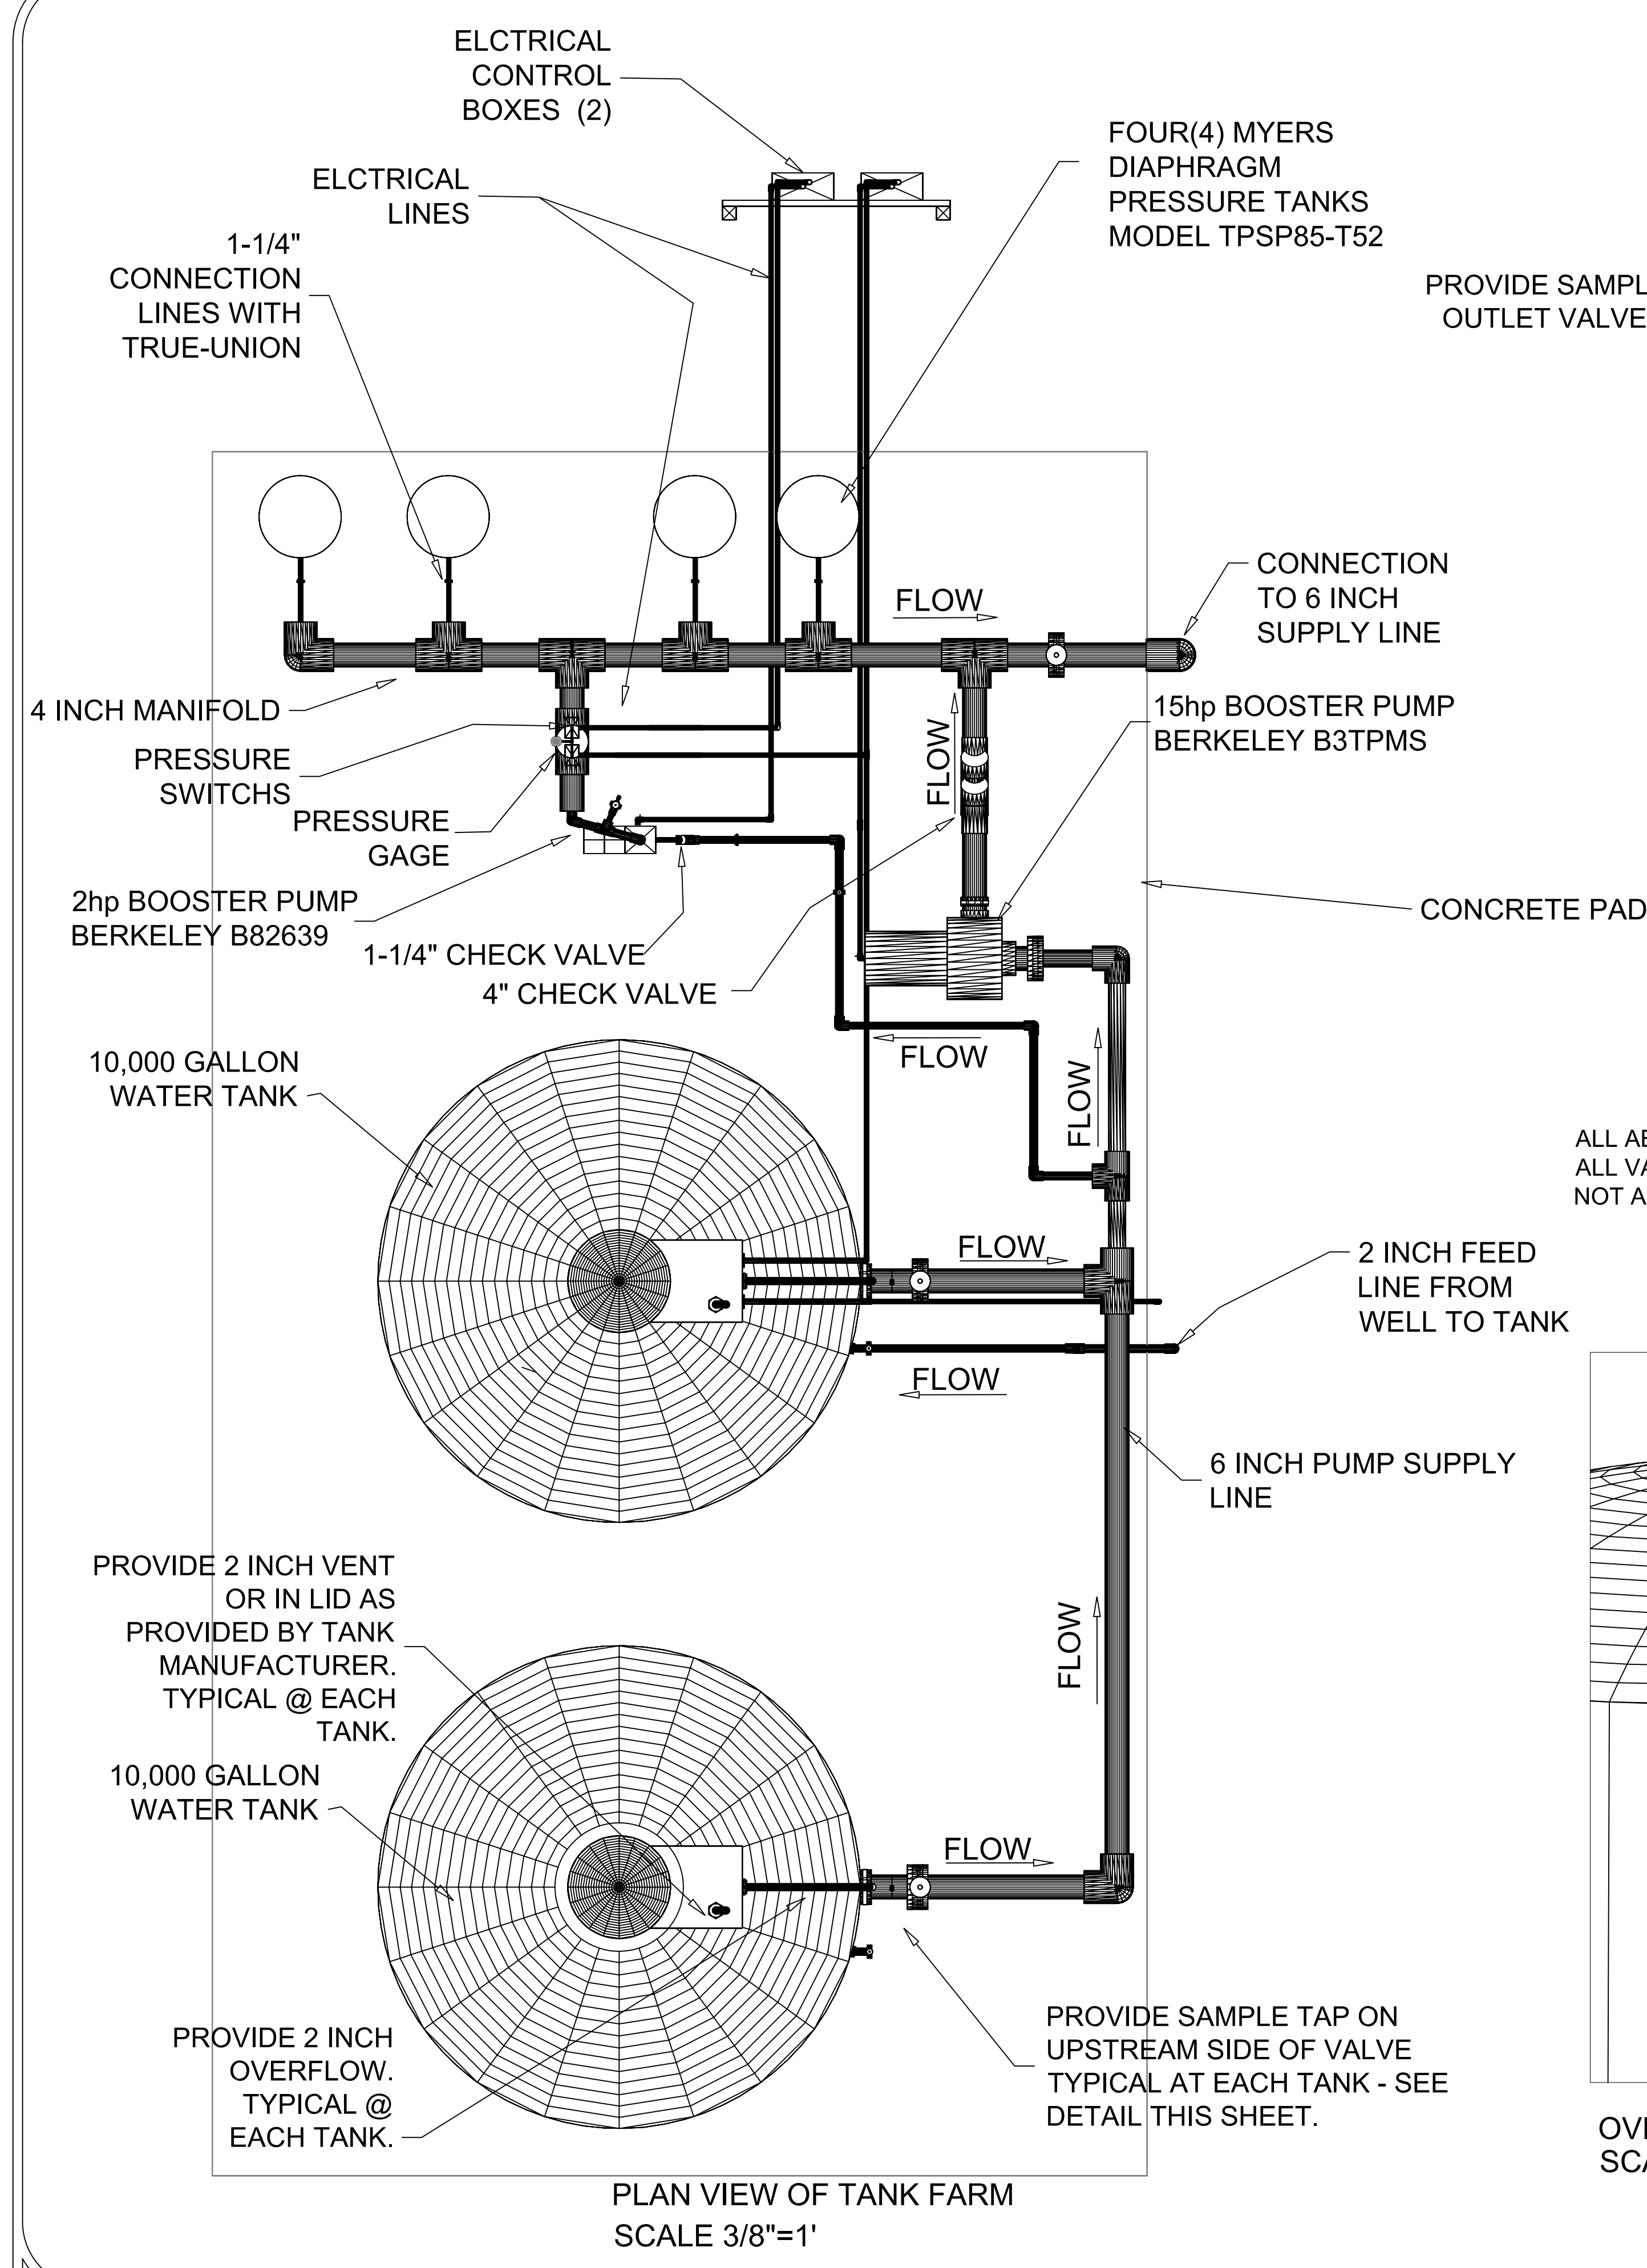


PLAN VIEW OF TANK FARM
SCALE 3/8"=1'

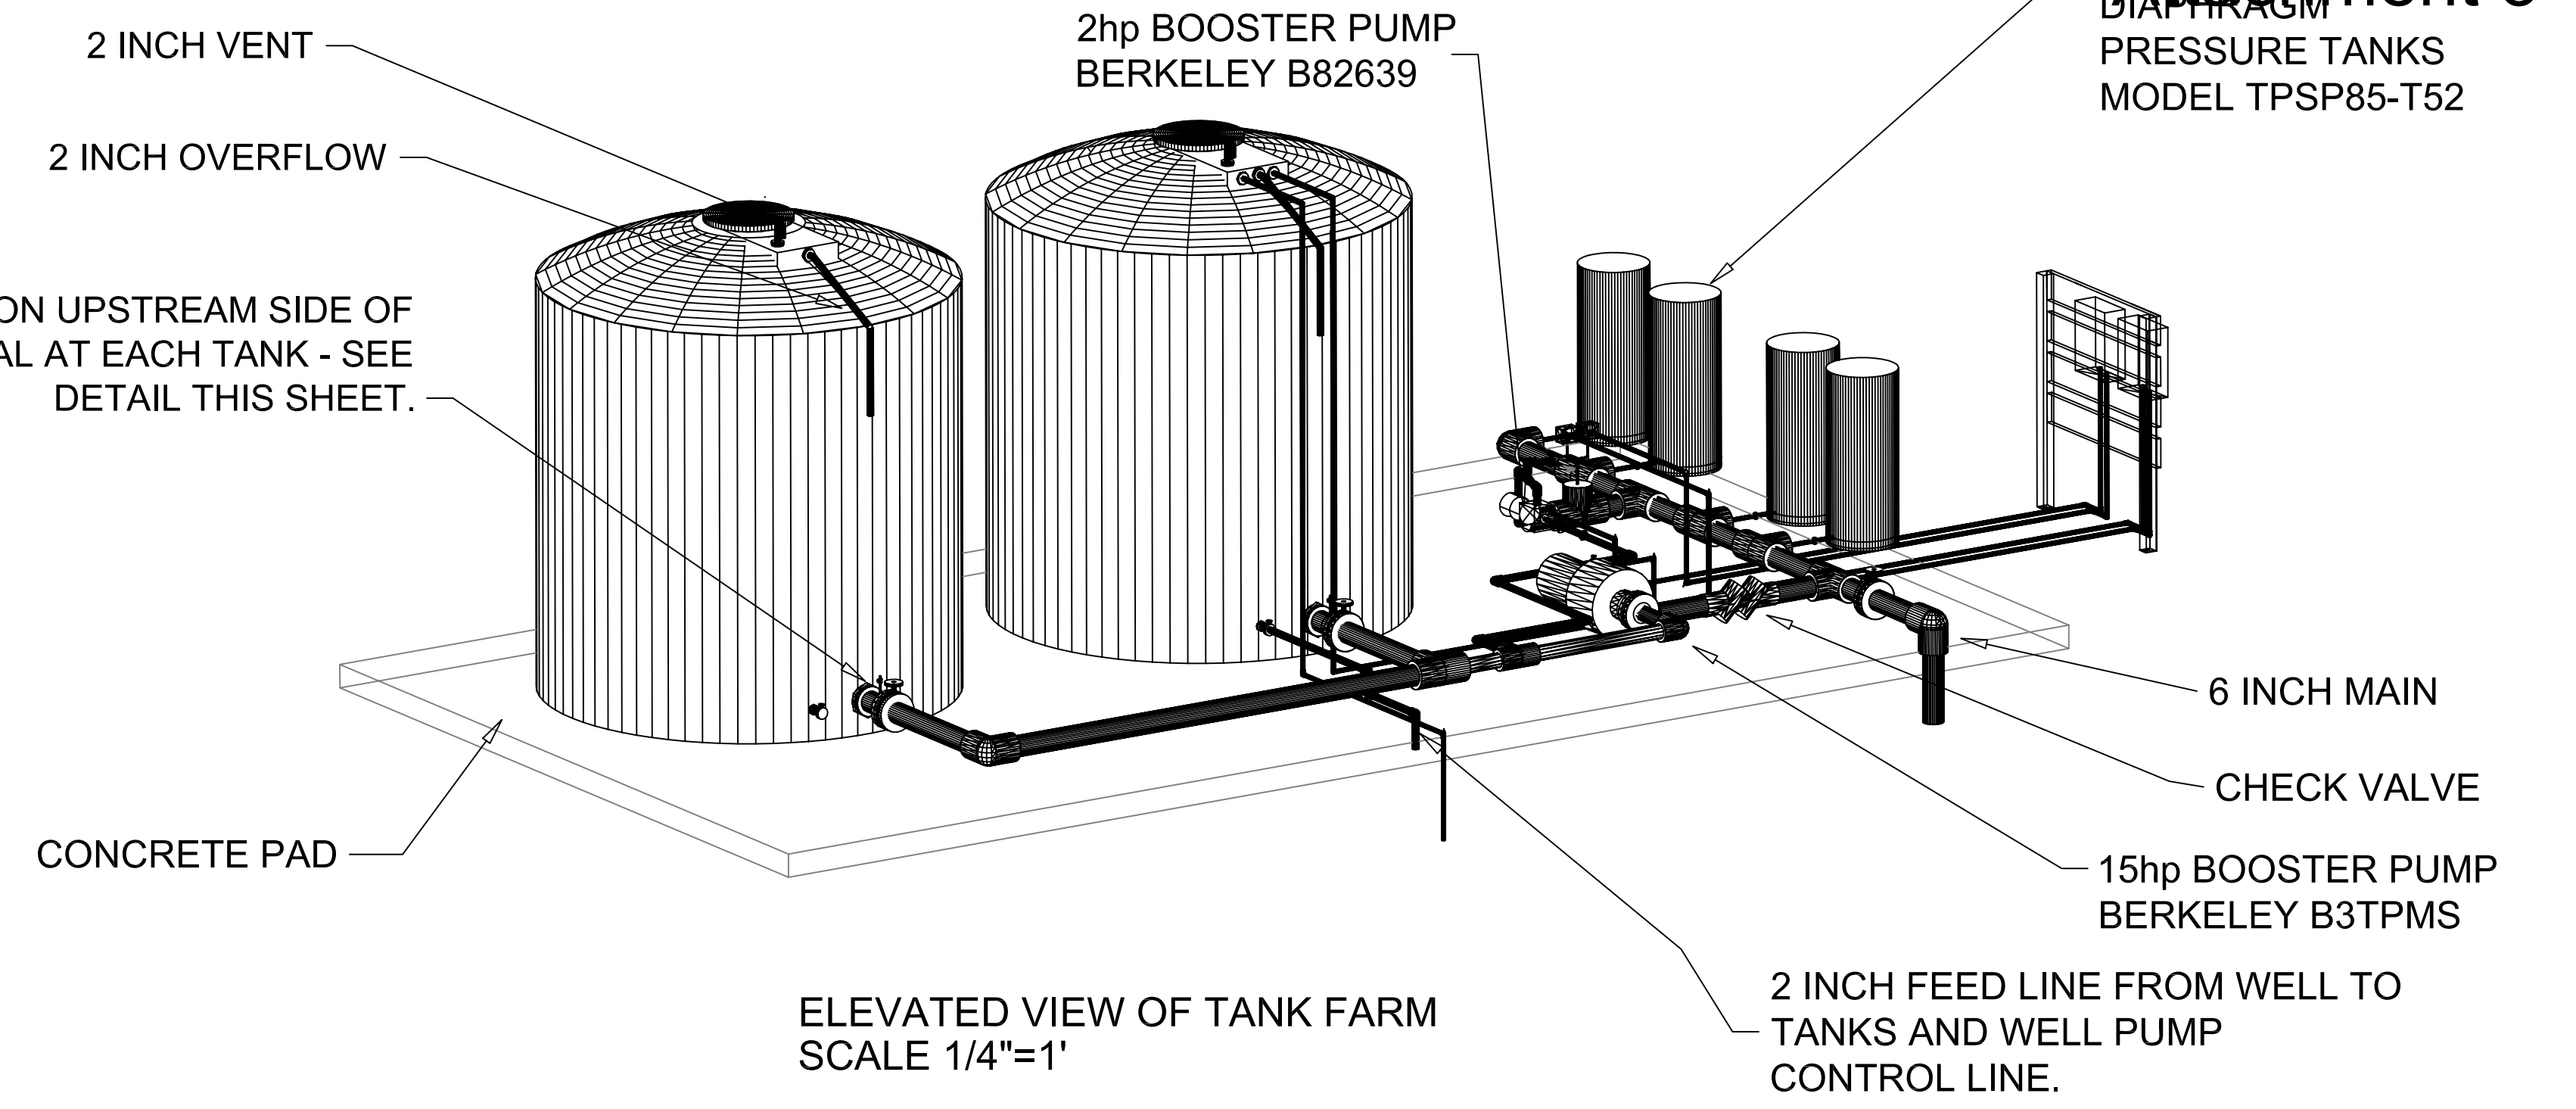


ELEVATED VIEW OF TANK FARM
SCALE 1/4"=1'

ALL ABOVE GRADE PIPES TO BE EITHER SCH. 40 GALVANIZED STEEL OR SCH. 80 P.V.C. PIPE. P.V.C. PIPE BELOW GRADE MAY BE SCH. 40. ALL VALVES TO BE INSTALLED AS TRUE UNION OR FLANGE. PROVIDE PROPER BUSHING(S) TO ACCOMMODATE SIZE CHANGE. NOT ALL TANK DETAILS SHOWN. NEW TANKS TO BE EITHER STEEL OR POLYETHYLENE. TANKS TO BE PLACED ON COCNRTE PAD ON ENGINEERED FILL.

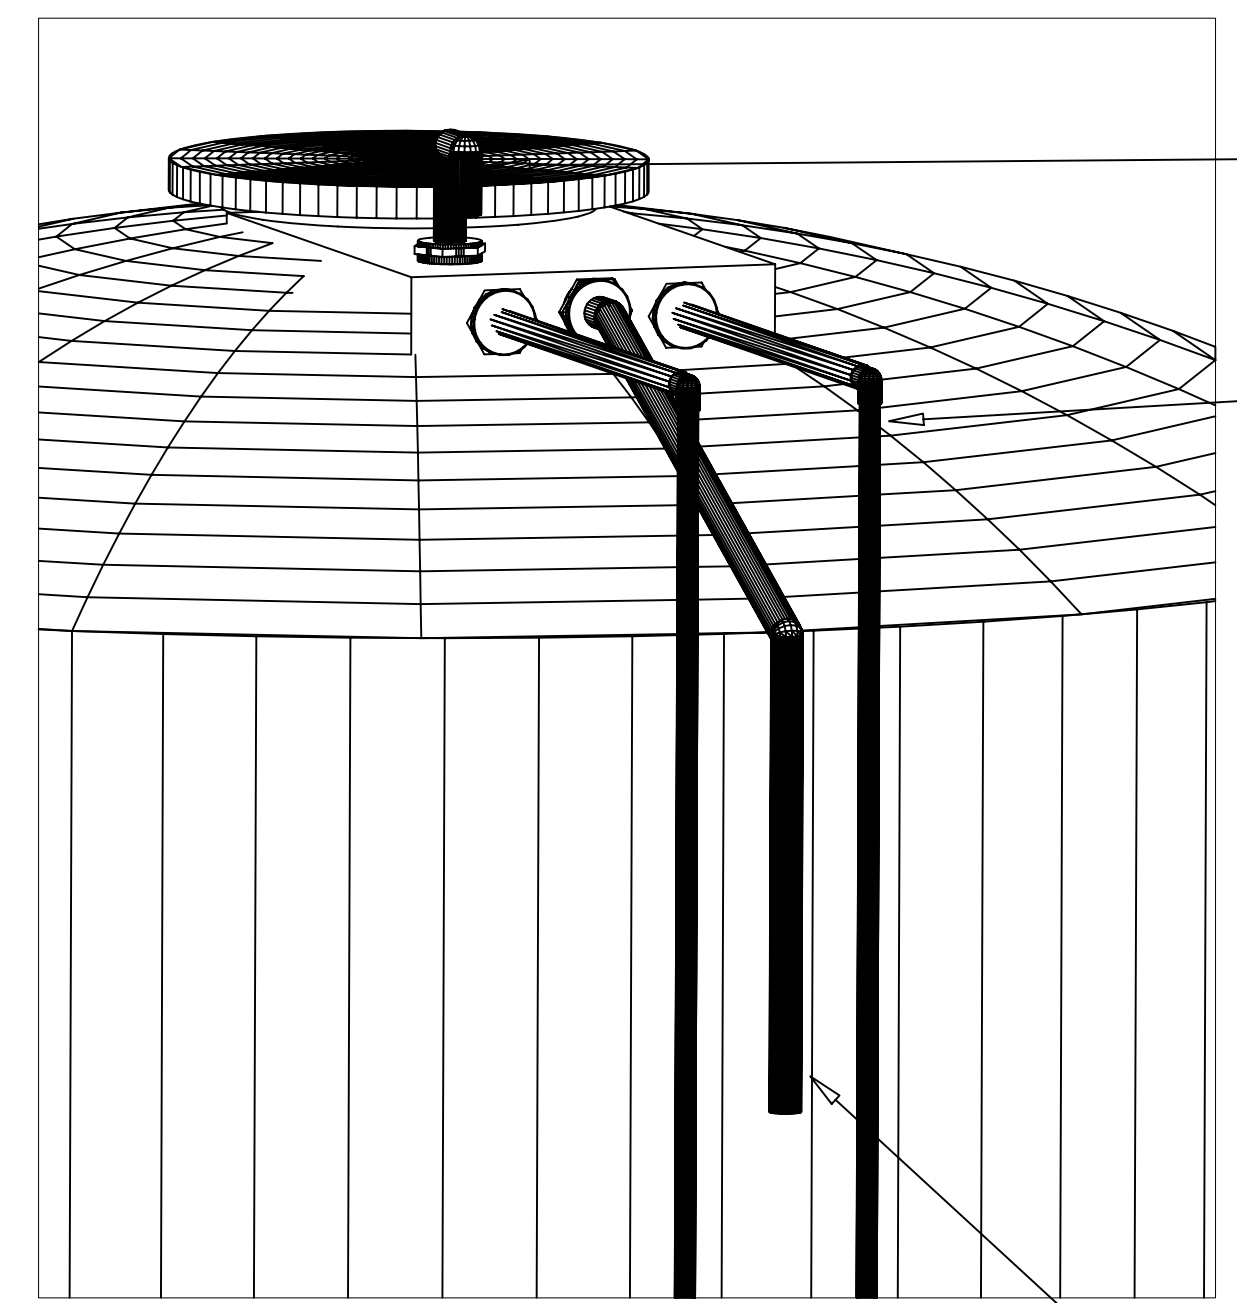

OVERFLOW & VENT DETAIL
SCALE 1" = 1'

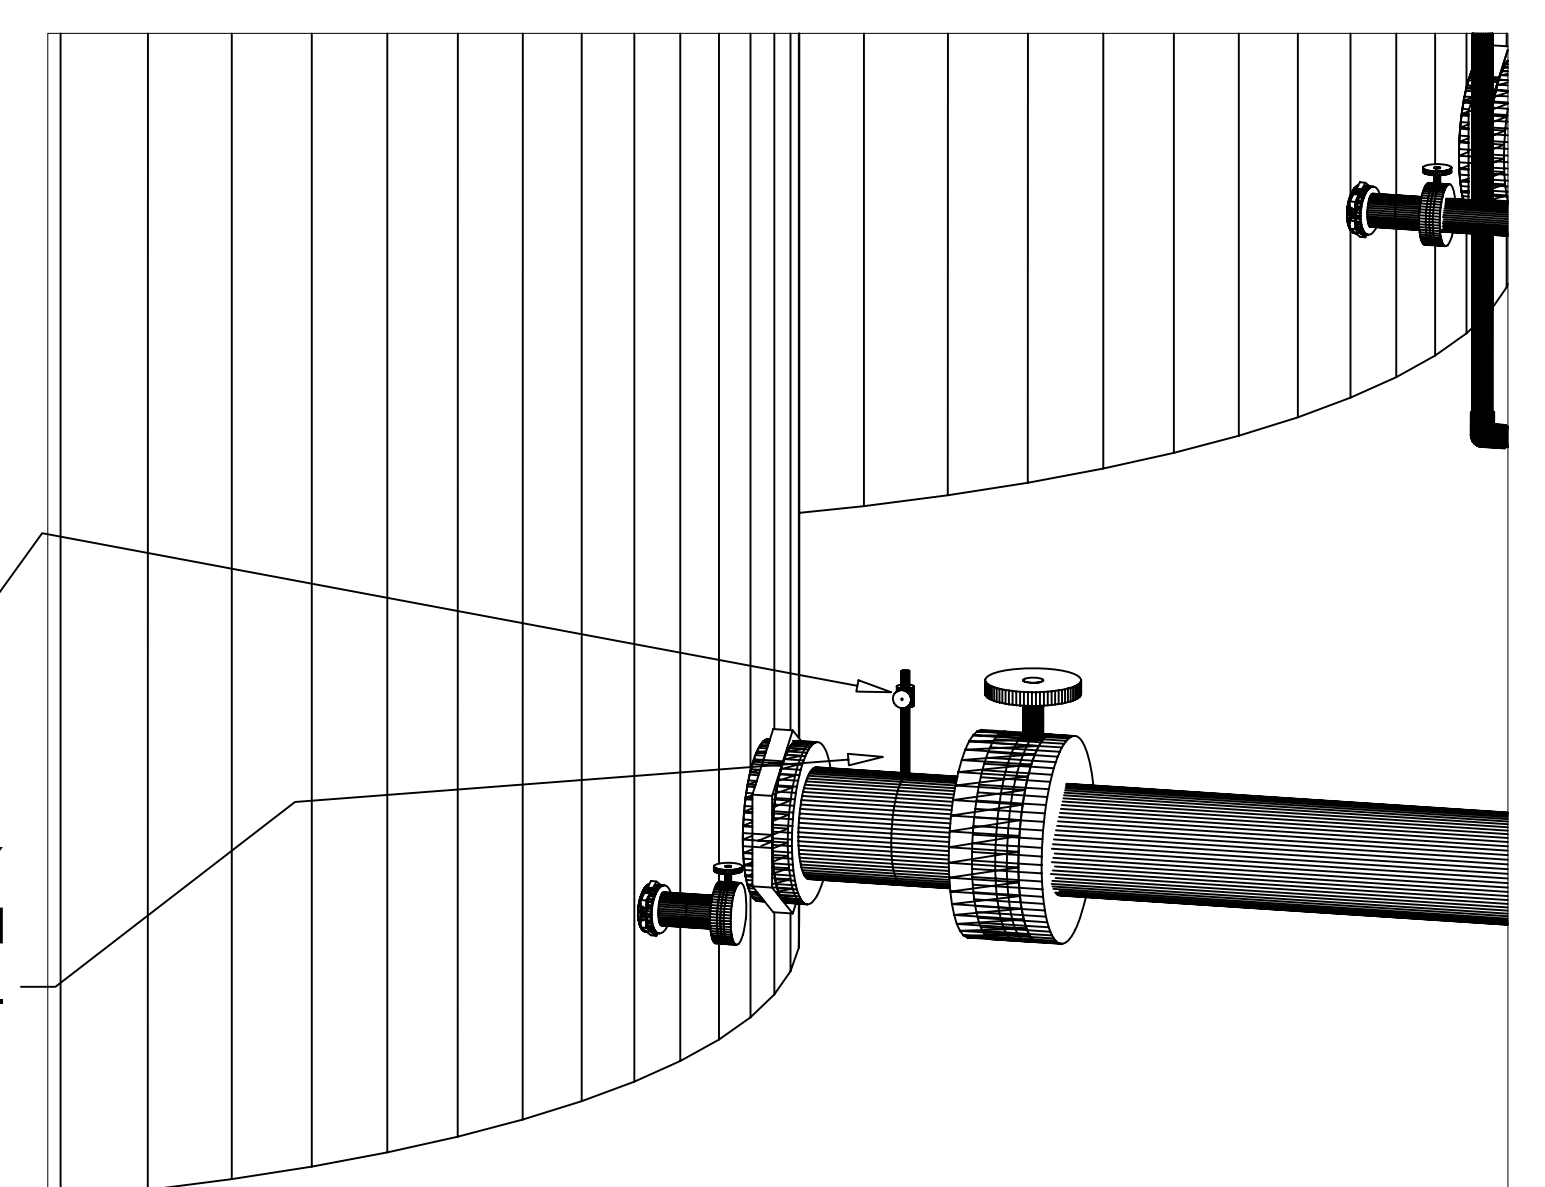

TANK SAMPLE TAP DETAIL
SCALE 1" = 1'

2 INCH PVC VENT, SCH. 80, TURN TO DOWNWARD POSITION. PROVIDE 3/8" SCREEN.



ELECTRIC CONTROL CONDUITS BY OTHERS

3/8" S.S. BALL VALVE.



3/8" S.S. TUBING. DIRECTLY TAPPED INTO P.V.C. PIPE ON TANK SIDE OF VALVE.

2 INCH PVC OVERFLOW, SCH. 80, CARRY OVER SIDE AND EXTEND DOWNWARD. TERMINATE NO CLOSER THAN 36 INCHES TO THE PAD SURFACE. PROVIDE 3/8" SCREEN AT OUTLET AND ADEQUATE SUPPORT.

- NOTES:
1. TIE OFF TRACER WIRE TO MAIN. DO NOT CONNECT TO WATER MAIN TRACER WIRE.
 2. TRACER WIRE SHALL BE INSTALLED ON ALL SERVICES.

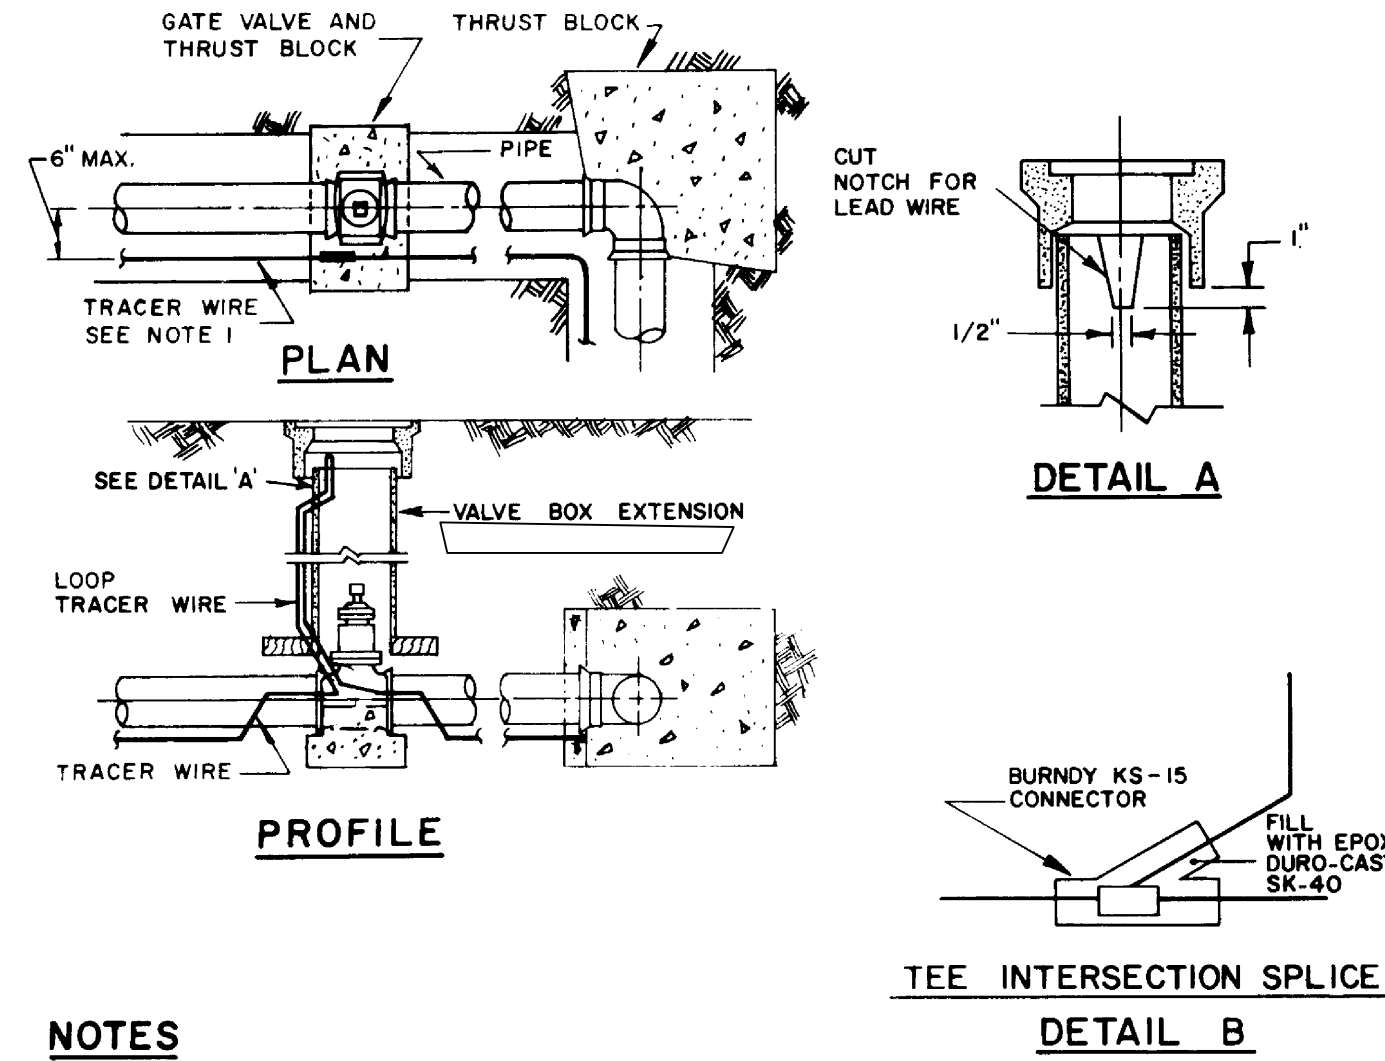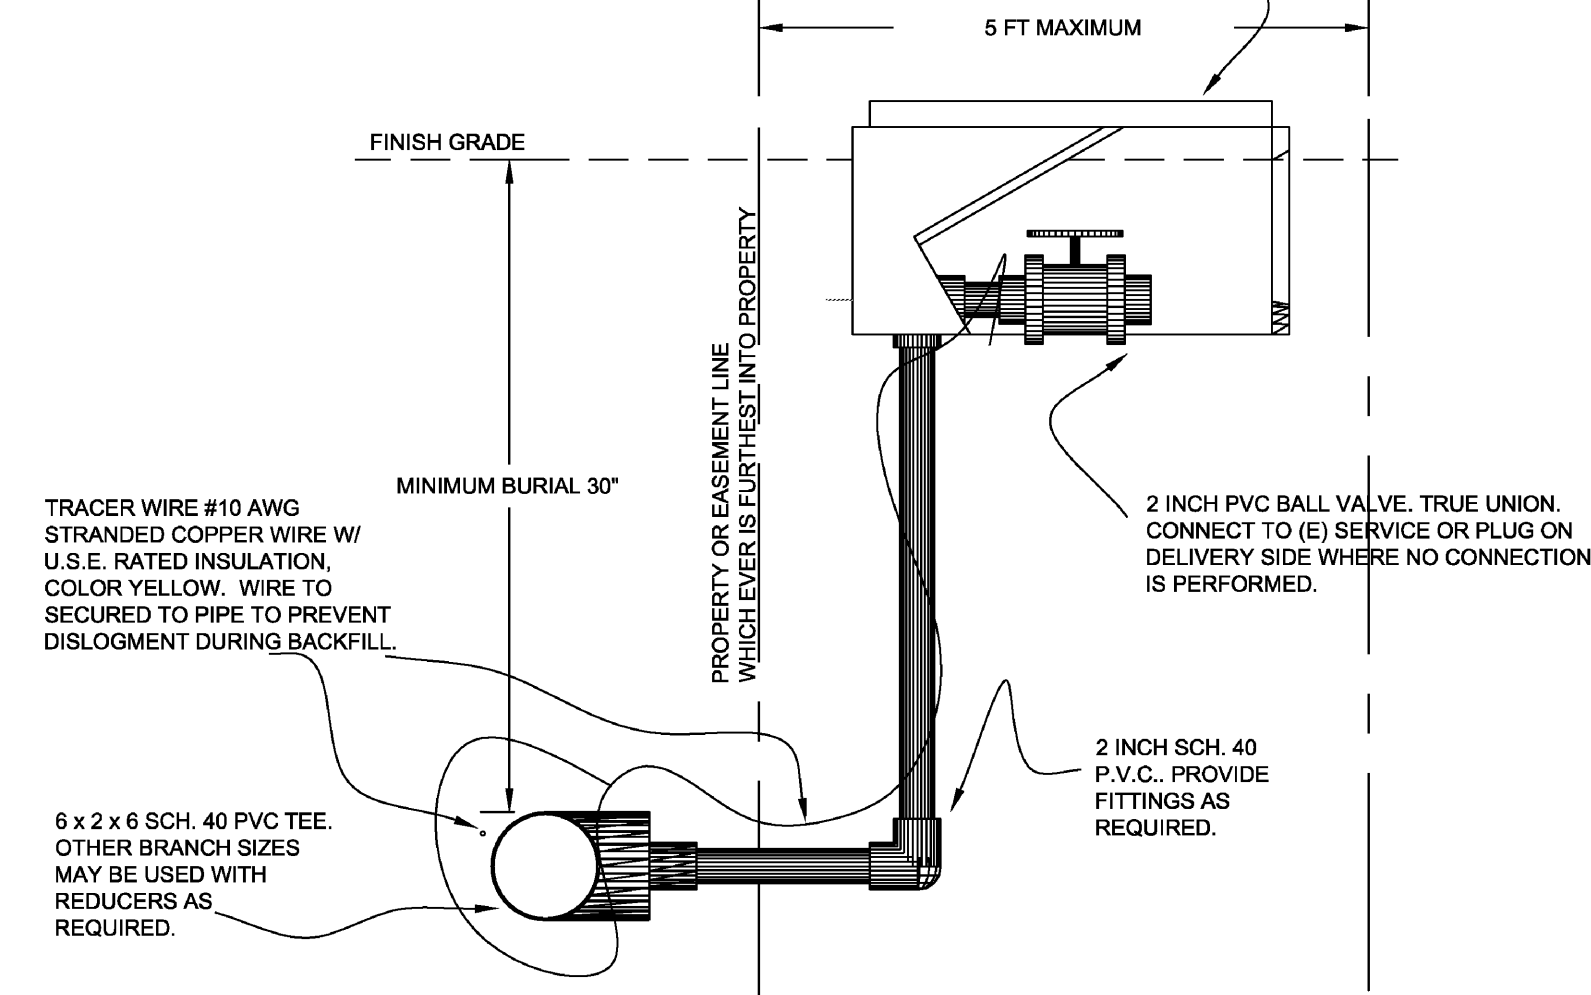

- NOTES:
1. CONTRACTOR SHALL USE CARE TO PREVENT DAMAGE TO TRACER WIRE WHEN PLACING CONCRETE.
 2. ALL WIRE SHALL BE STRANDED COPPER W/ U.S.E. RATED INSULATION, COLOR YELLOW MIN. SIZE AWG 10.
 3. SPLICES SHALL BE MADE WITH SCREW TYPE CONNECTORS, BURNDY SERVIET KS-15, AND ENCAPSULATED IN EPOXY, DURO-CAST UNIVERSAL MODEL SK-40. SEE DETAIL B.
 4. TRACER WIRES SHALL BE INTER-CONNECTED AT PIPE TEES AND CROSSES.
 5. CONTINUITY TESTS SHALL BE CONDUCTED AS DIRECTED BY THE DISTRICT.
 6. TRACER WIRE REQUIRED ON ALL NON-FERROUS MAINS.

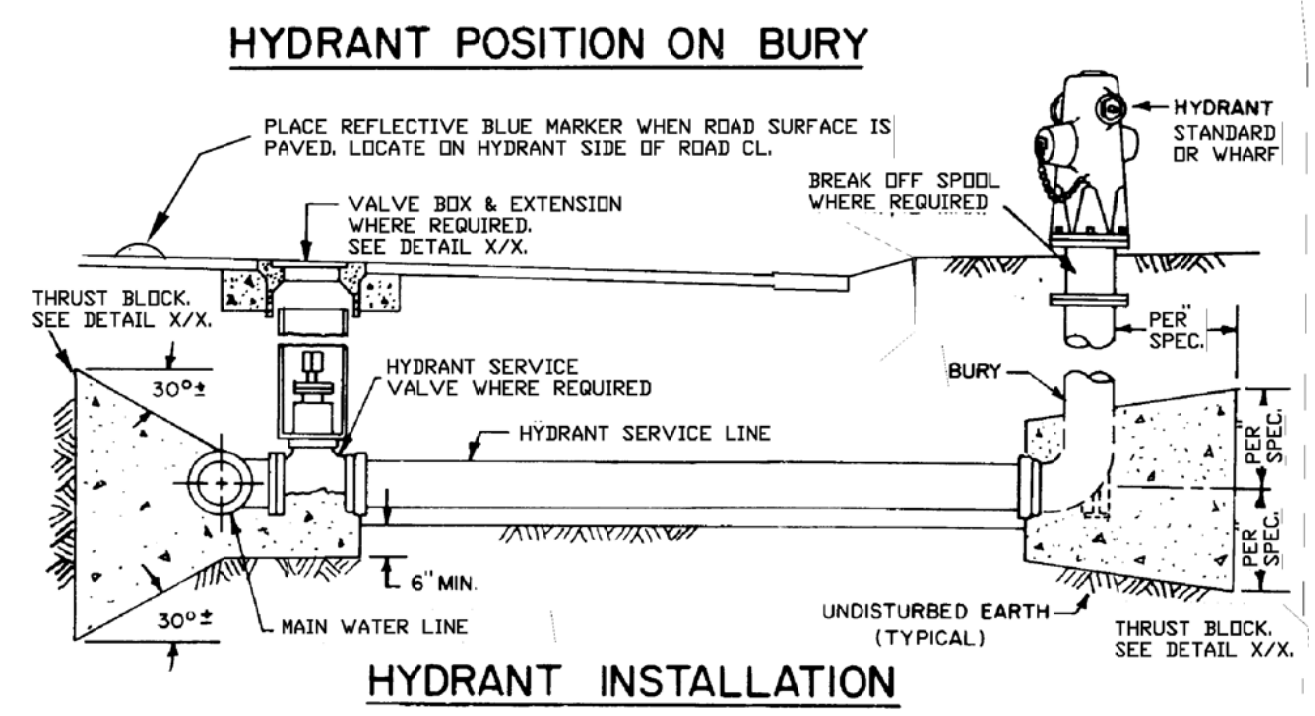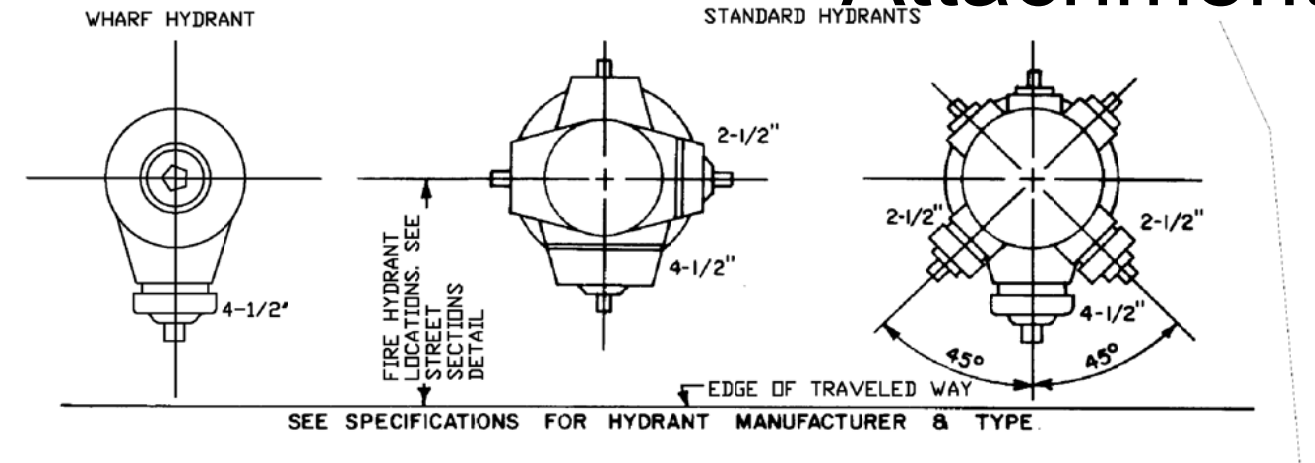


- NOTES:
1. COAT ALL FERROUS METAL, PRIOR TO PLACEMENT IN TRENCH IN ACCORDANCE WITH SPECIFICATIONS.
 2. FOR FIRE HYDRANT PAINT COLOR, SEE SECTION F.9 OF ACWD STANDARD SPECIFICATIONS.
 3. SLETTED HYDRANT SPOOLS MAY BE REQUIRED FOR SPECIAL CONDITIONS, SUCH AS HYDRANTS LOCATED IN GULL-DE-SACS, LONG RADIUS CURVES, ETC.
 4. CAST CONCRETE AGAINST UNDISTURBED EARTH.

1 2 inch Service Line and Tracer Wire Installation Details

2 Mains and Valves Tracer Wire Installation Details

3 Fire Hydrants Installation Details

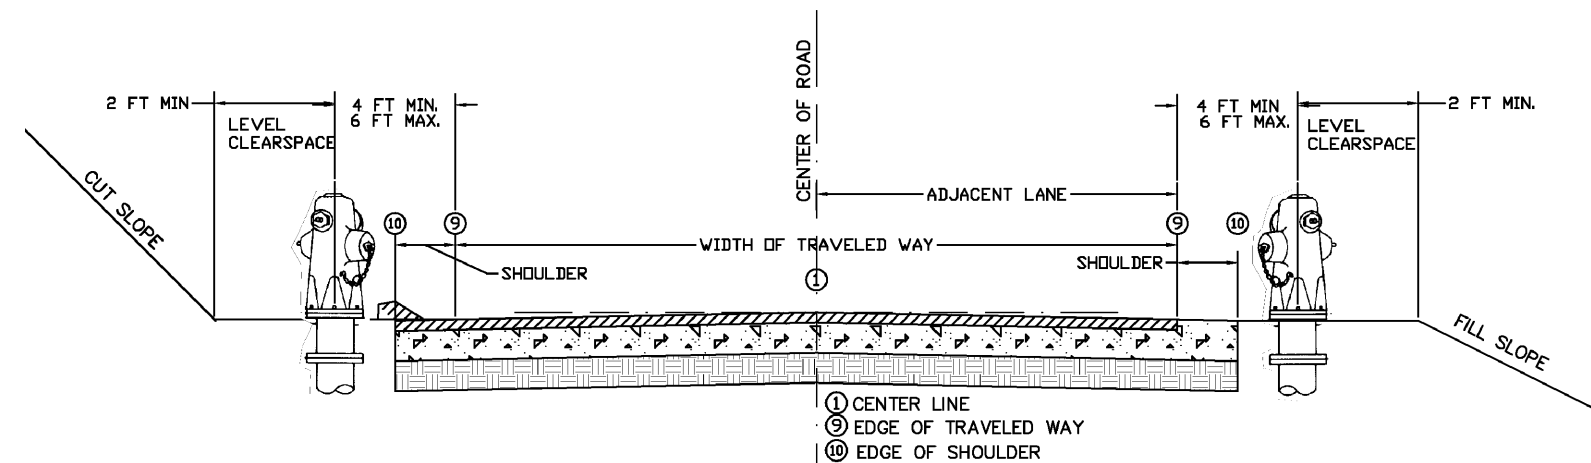

TYPICAL HYDRANT PLACEMENT ON PRIVATE ROAD

ALL FLAMMABLE VEGETATION WITHIN 8 FEET OF HYDRANT SHALL BE CLEARED.

WHERE THE ADJACENT ROAD SURFACE IS PAVED, A REFLECTORIZED BLUE MARKER SHALL BE PERMANENTLY GLUED TO THE PAVEMENT TO THE HYDRANT SIDE OF THE CENTERLINE.

EACH HYDRANT/FIRE VALVE OR ACCESS TO WATER SHALL BE IDENTIFIED AS FOLLOWS:

A. IF LOCATED ALONG A DRIVEWAY, A REFLECTORIZED BLUE MARKER, WITH A MINIMUM DIMENSION OF 3 INCHES, SHALL BE LOCATED ON THE DRIVEWAY ADDRESS SIGN AND MOUNTED ON A FIRE RETARDANT POST.

B. IF LOCATED ALONG A STREET OR ROAD, A REFLECTORIZED BLUE MARKER, WITH A MINIMUM DIMENSION OF 3 INCHES, SHALL BE MOUNTED ON A FIRE RETARDANT POST. THE SIGN POST SHALL BE WITHIN 3 FEET OF SAID HYDRANT/FIRE VALVE, WITH A SIGN NO LESS THAN 3 FEET NOR GREATER THAN 5 FEET ABOVE GROUND, IN A HORIZONTAL POSITION AND VISIBLE FROM THE DRIVEWAY.

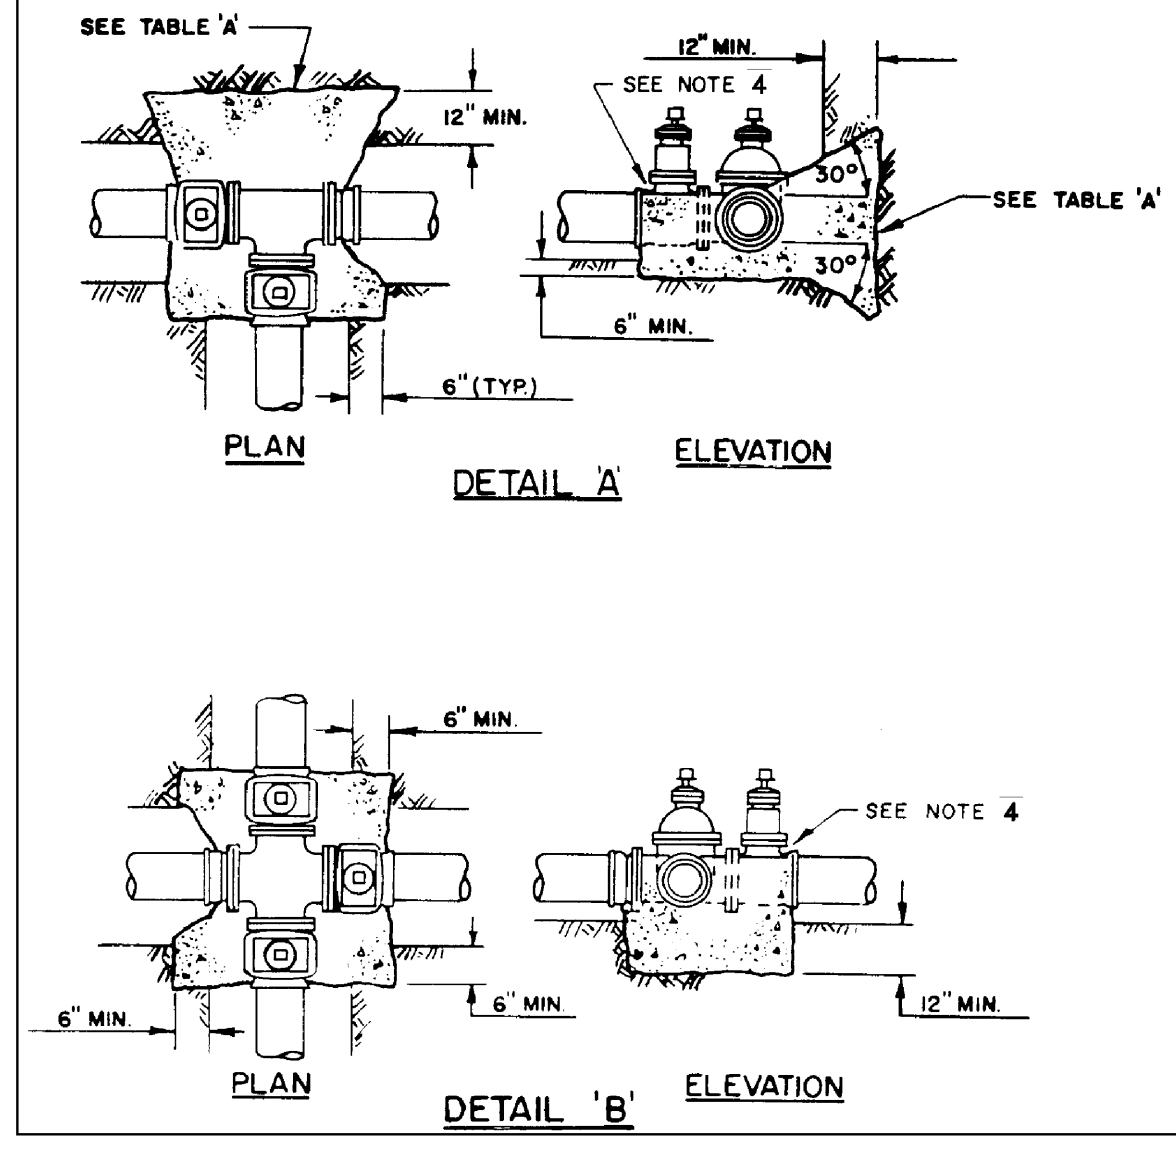



TABLE A

PIPE DIAMETER	SQUARE FEET
4"	3
6"	5
8"	8
10"	12
12"	17
14"	24
16"	31

NOTES:

1. DETAILS BASED ON 150 P.S.I. PRESSURE, 1,000 P.S.F. SOIL BEARING. USE 6 SACK, 3/4 AGG. MAX. CONCRETE MIX.
2. COAT FITTINGS WITH MASTIC OR WRAP IN PLASTIC WHERE EMBEDDED IN CONCRETE TO FACILITATE DISS-ASSEMBLY.
3. CAST CONCRETE THRUST BLOCK AGAINST FIRM, UNDISTURBED EARTH.
4. MAINTAIN CLEARANCE FOR BONNET BOLT REMOVAL WHERE APPLICABLE.

NO THRUST BLOCKING REQUIRED FOR SOLVENT WELD OR THREADED PIPE SMALLER THAN 4 INCHES.

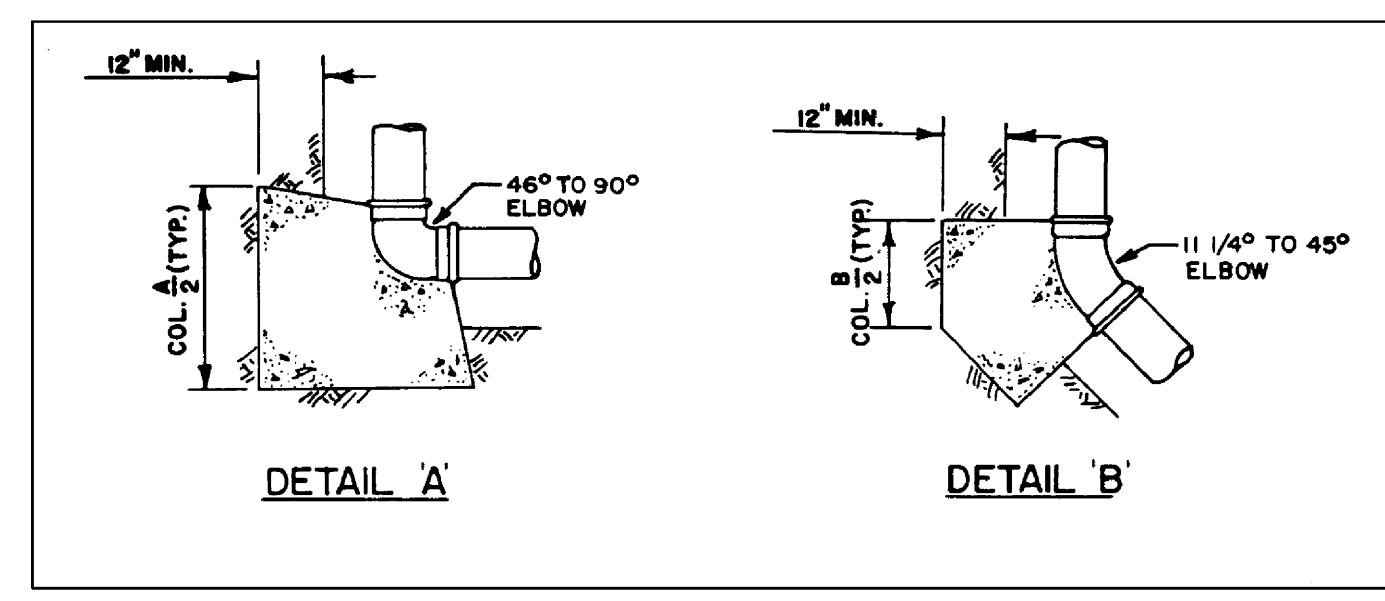

PIPE DIAMETER	REQUIRED BEARING AREAS - SQ FT	
	A	B
4"	4	3
6"	6	4
8"	11	6
10"	17	9
12"	24	13
14"	33	18
16"	43	23

NOTES:

1. DETAILS BASED ON 150 P.S.I. PRESSURE, 1,000 P.S.F. SOIL BEARING. USE 6 SACK, 3/4 AGG. MAX. CONCRETE MIX.
2. COAT FITTING WITH MASTIC OR WRAP IN PLASTIC WHERE EMBEDDED IN CONCRETE TO FACILITATE DISS-ASSEMBLY.
3. CAST CONCRETE THRUST BLOCK AGAINST FIRM, UNDISTURBED EARTH.



NO THRUST BLOCKING REQUIRED FOR SOLVENT WELD OR THREADED PIPE SMALLER THAN 4 INCHES.

5 Fire Hydrant Locations Installation Details

6 Valve Cluster Thrust Blocking PVC Pipe Installation Details

7 Thrust Blocking for Horizontal Fittings PVC Pipe Installation Details

8 Fire Hydrants Installation Details

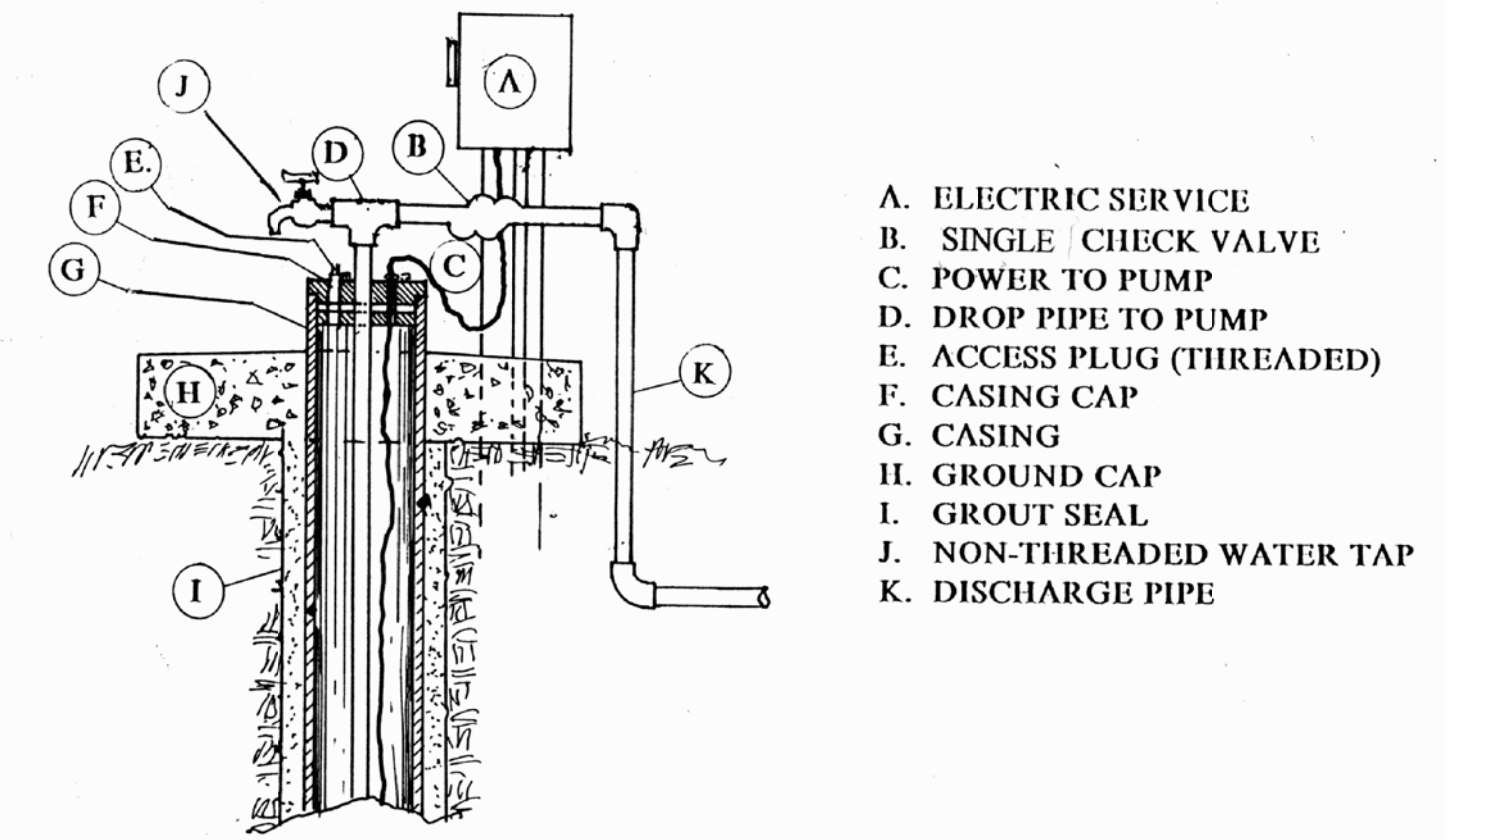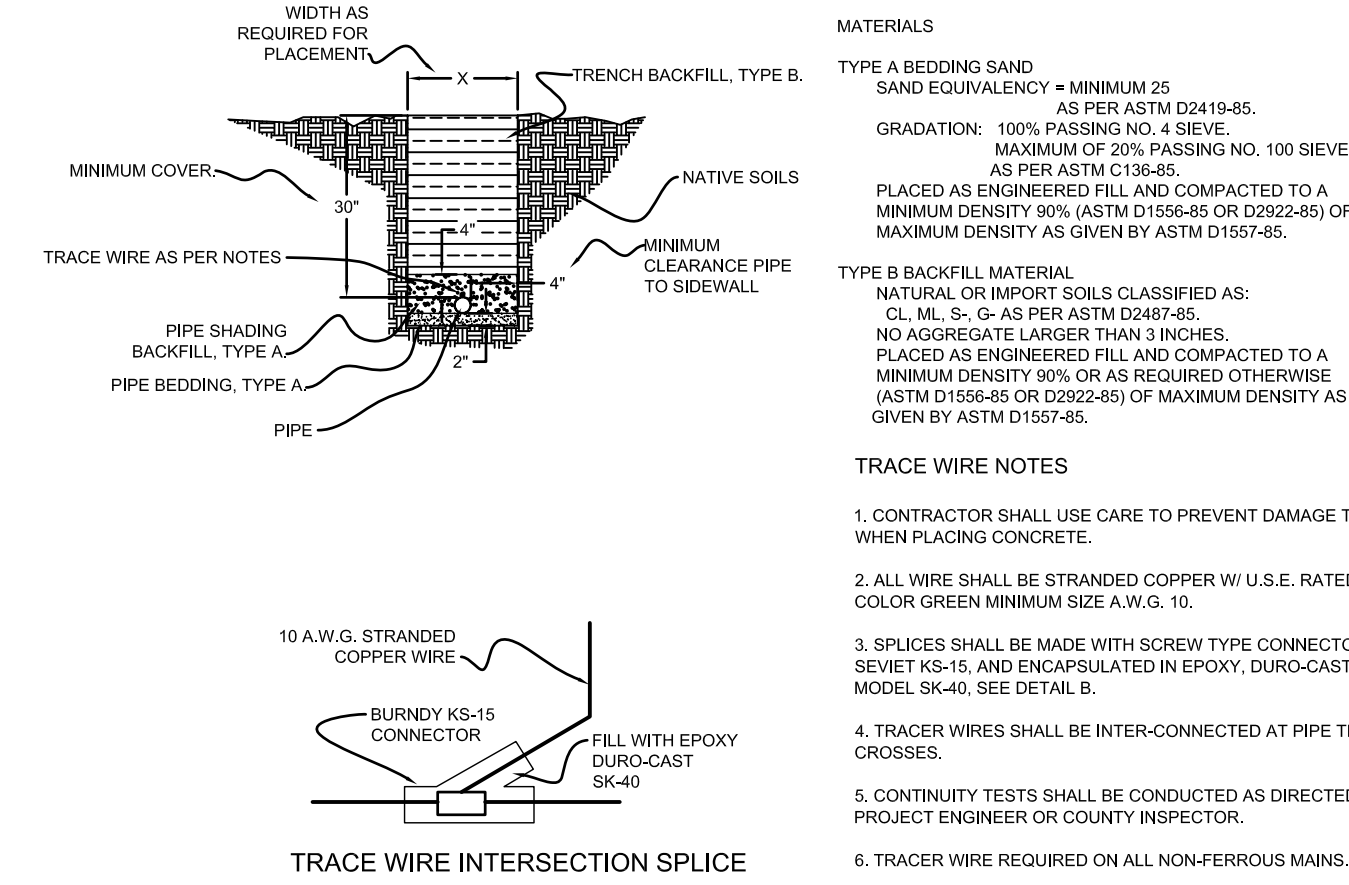


1

2

3 Water Pipe Trench Installation Details

4 Well Connection Installation Details

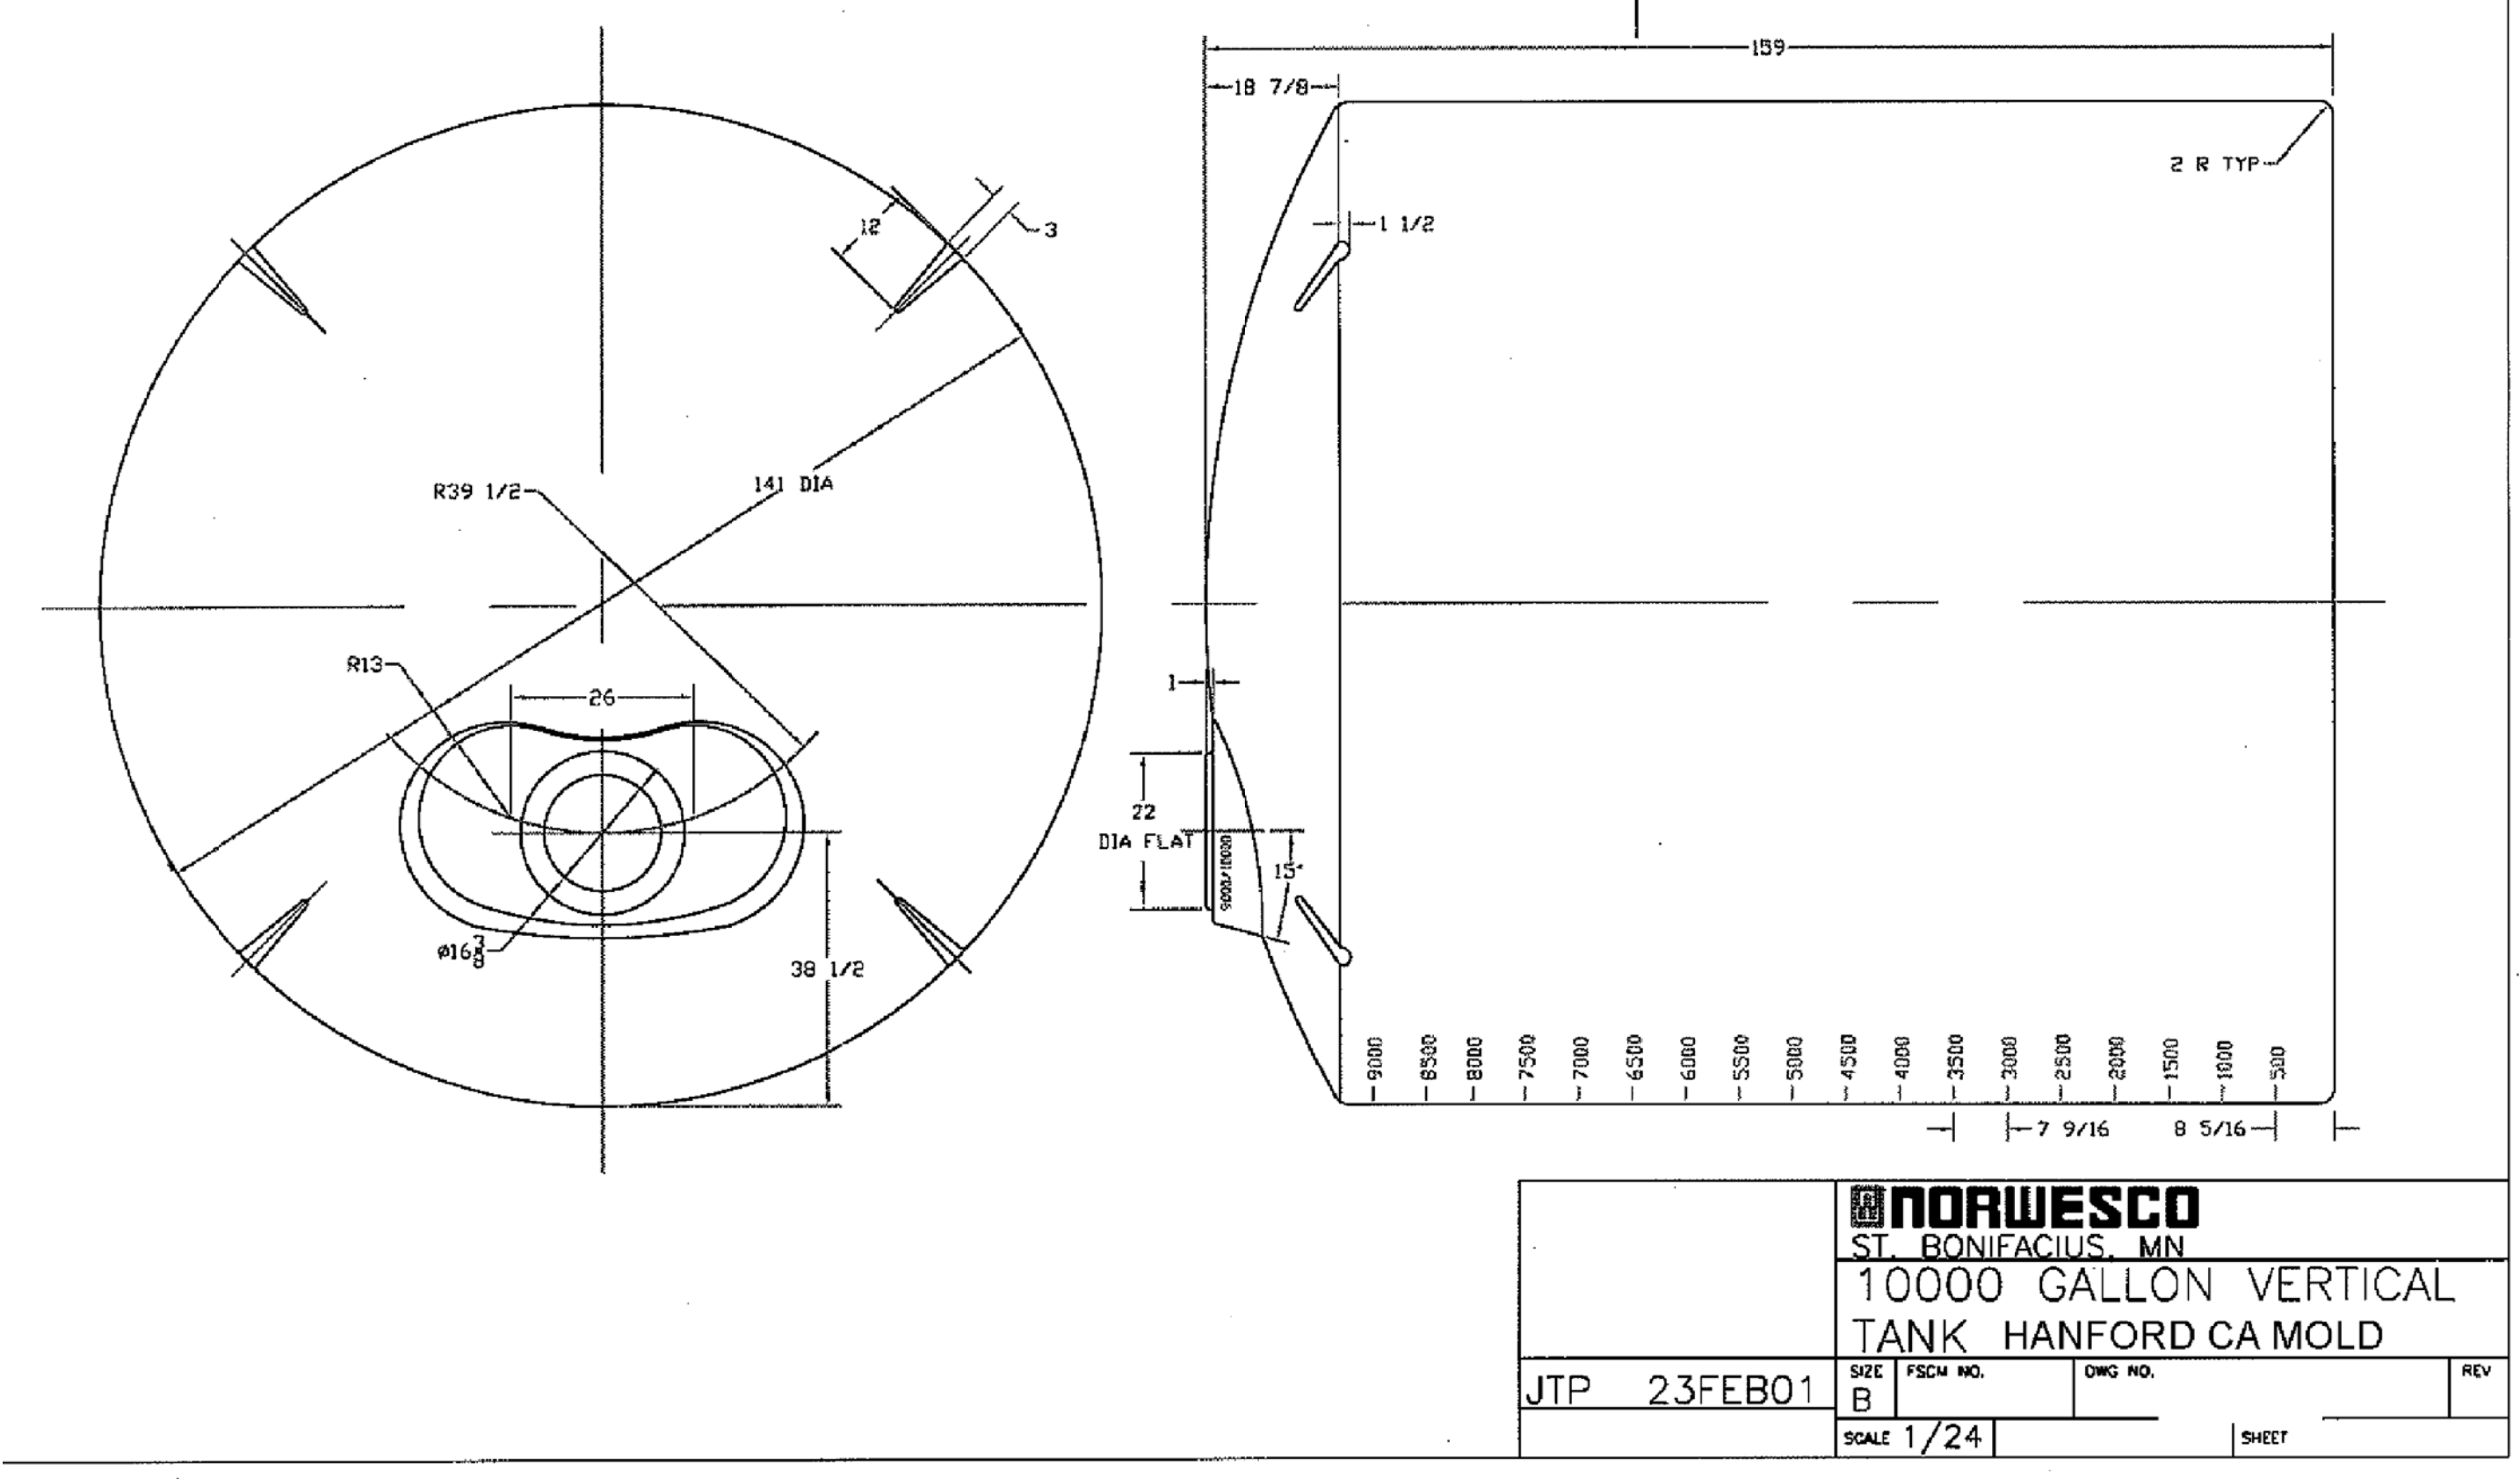

5

6

8 WATER TANK

