

Attachment D

This page intentionally left blank.

ATTACHMENT D
1 OF 2

02861

Vol. 1, Pg. 64

Copied from original map filed in
Book No 1 Pg. 64 of Cities & Towns

The Arroyo Seco Improvement Company, a corporation organized and doing business under the laws of the State of New Jersey, with its principal branch office in the City of Peoria, Illinois and authorized to do business in the State of California, hereby certifies that it is the proprietor of the property subdivided as shown by this map; that it has caused such subdivision and map to be made; and hereby dedicates for public use all those portions marked as "Camino Real", streets, avenues and alleys, but said corporation hereby excepts therefrom and reserves to itself and its successors and assigns a continuous right of way 35 feet wide over and along the most eastern portion of Canal Street for its entire length; a continuous right of way 10 feet wide on each side of the center line of Walnut Avenue for its entire length; a continuous right of way 20 feet wide along the most eastern portion of Twelfth Street for its entire length; a continuous right of way 10 feet wide on each side of the center line of Apple Avenue from Twelfth Street Westerly to the South West corner of Lot No. 188; a continuous right of way 20 feet wide along the most southern portion of Oak Avenue from the south west corner of Lot No. 79 easterly to Eleventh Street; a continuous right of way 20 feet wide along the most northerly portion of Elm Avenue for its entire length; all of the said rights of way so reserved being for the purpose of constructing, operating and maintaining canals, laterals, ditches, conduits and waterways on, over and through any and all of said highways, streets, avenues and alleys shown on said map; pipes, mains, tunnels and conduits for the construction, operation and maintenance of a general water system for Clark City.

Duly executed at the city of Peoria, State of Illinois, by the said corporation on the 6th day of JULY, 1905.
ARROYO SECO IMPROVEMENT COMPANY
by S.O. SPRING, President.
E.J. CASE, Secretary.

Filed at the request of C.M. WOOSTER
JULY 19, 1905 at 55 minutes past 11 A.M.
Vol. 1, pg. 64, Cities and Towns.
RW 16070
Fees: \$0.50 (pd) County Recorder.

It is ordered that all streets, alleys and highways offered by this map, be and the same are hereby accepted on behalf of the public.

Dated this 5th day of September, 1905
T.J. FIELD,
Chairman of the Board of Supervisors
of Monterey County, California.

Attest: J.D. KALAR,
Clerk of said Board.

MAP
OF THE
CLARK COLONY
MONTEREY COUNTY, CALIF.
SURVEYED BY H.B. FISHER, SURVEYOR & C.E. 1905
Scale 1 in. = 10 chains.

THORNE
ROAD

Sheet No 1 of 3 sheets

ARROYO SECO
ROAD (APPROX)

Note: The CLARK COLONY is a subdivision of the South Easterly part of the Arroyo Seco Rancho; Distances are given in chains and fractions thereof; Areas and distances go to the Easterly line of Spruce Ave along Lots 396 & 397 and to the center of said Ave along Lots 390 & 395; to the Westerly line of Cedar and Fir Avenues, to the Easterly line of Ninth Street and Canal Street; to the South line of the Arroyo Seco Rancho along Elm Ave; to the North line of Almond Ave; to the Westerly line of Peach Ave; to the Westerly line of Eighth St. and to the center line of all other Streets and Avenues (excepting 12th St where they go to a line 5 ft. east of the center).
■ represents 6 in. x 6 in. underground wooden monuments.
Red lines represent, on Canal St. 35 ft. Canal right of way, on other Streets and Avenues 20 ft. irrigation ditch right of way.
(Red lines are shown thus ————)

State of Illinois } 55
County of Peoria


On this 6th day of JULY in the year one thousand nine hundred and five, before me FREDERICK A. BRACKEN, Notary Public in and for the County of Peoria, State of Illinois, residing therein, duly commissioned and sworn, personally appeared S.O. SPRING known to me to be the President and E.J. CASE known to me to be the Secretary of the Corporation that executed the within instrument and acknowledged to me that such corporation executed the same.

IN WITNESS WHEREOF, I have here unto set my hand and affixed my official seal in said County, the day and year in this certificate first above written.


FREDERICK A. BRACKEN
Notary Public in and for Peoria County,
State of Illinois

My commission expires JUNE 1908.

COUNTY ROAD RIGHTS-OF-WAY (RED)
NOT COUNTY MAINTAINED - TO BE VACATED

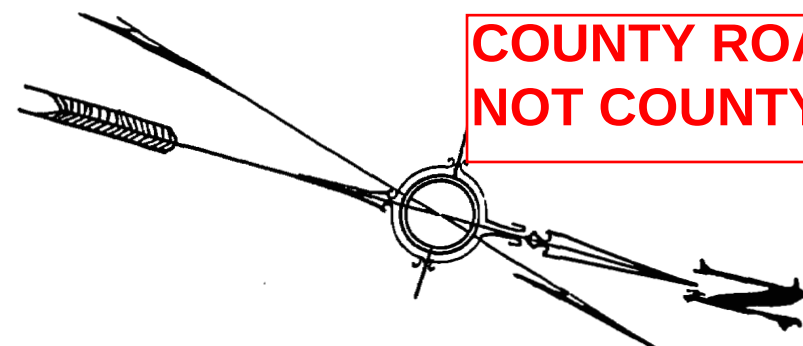

Match Mark - 2
N 32° 49' W

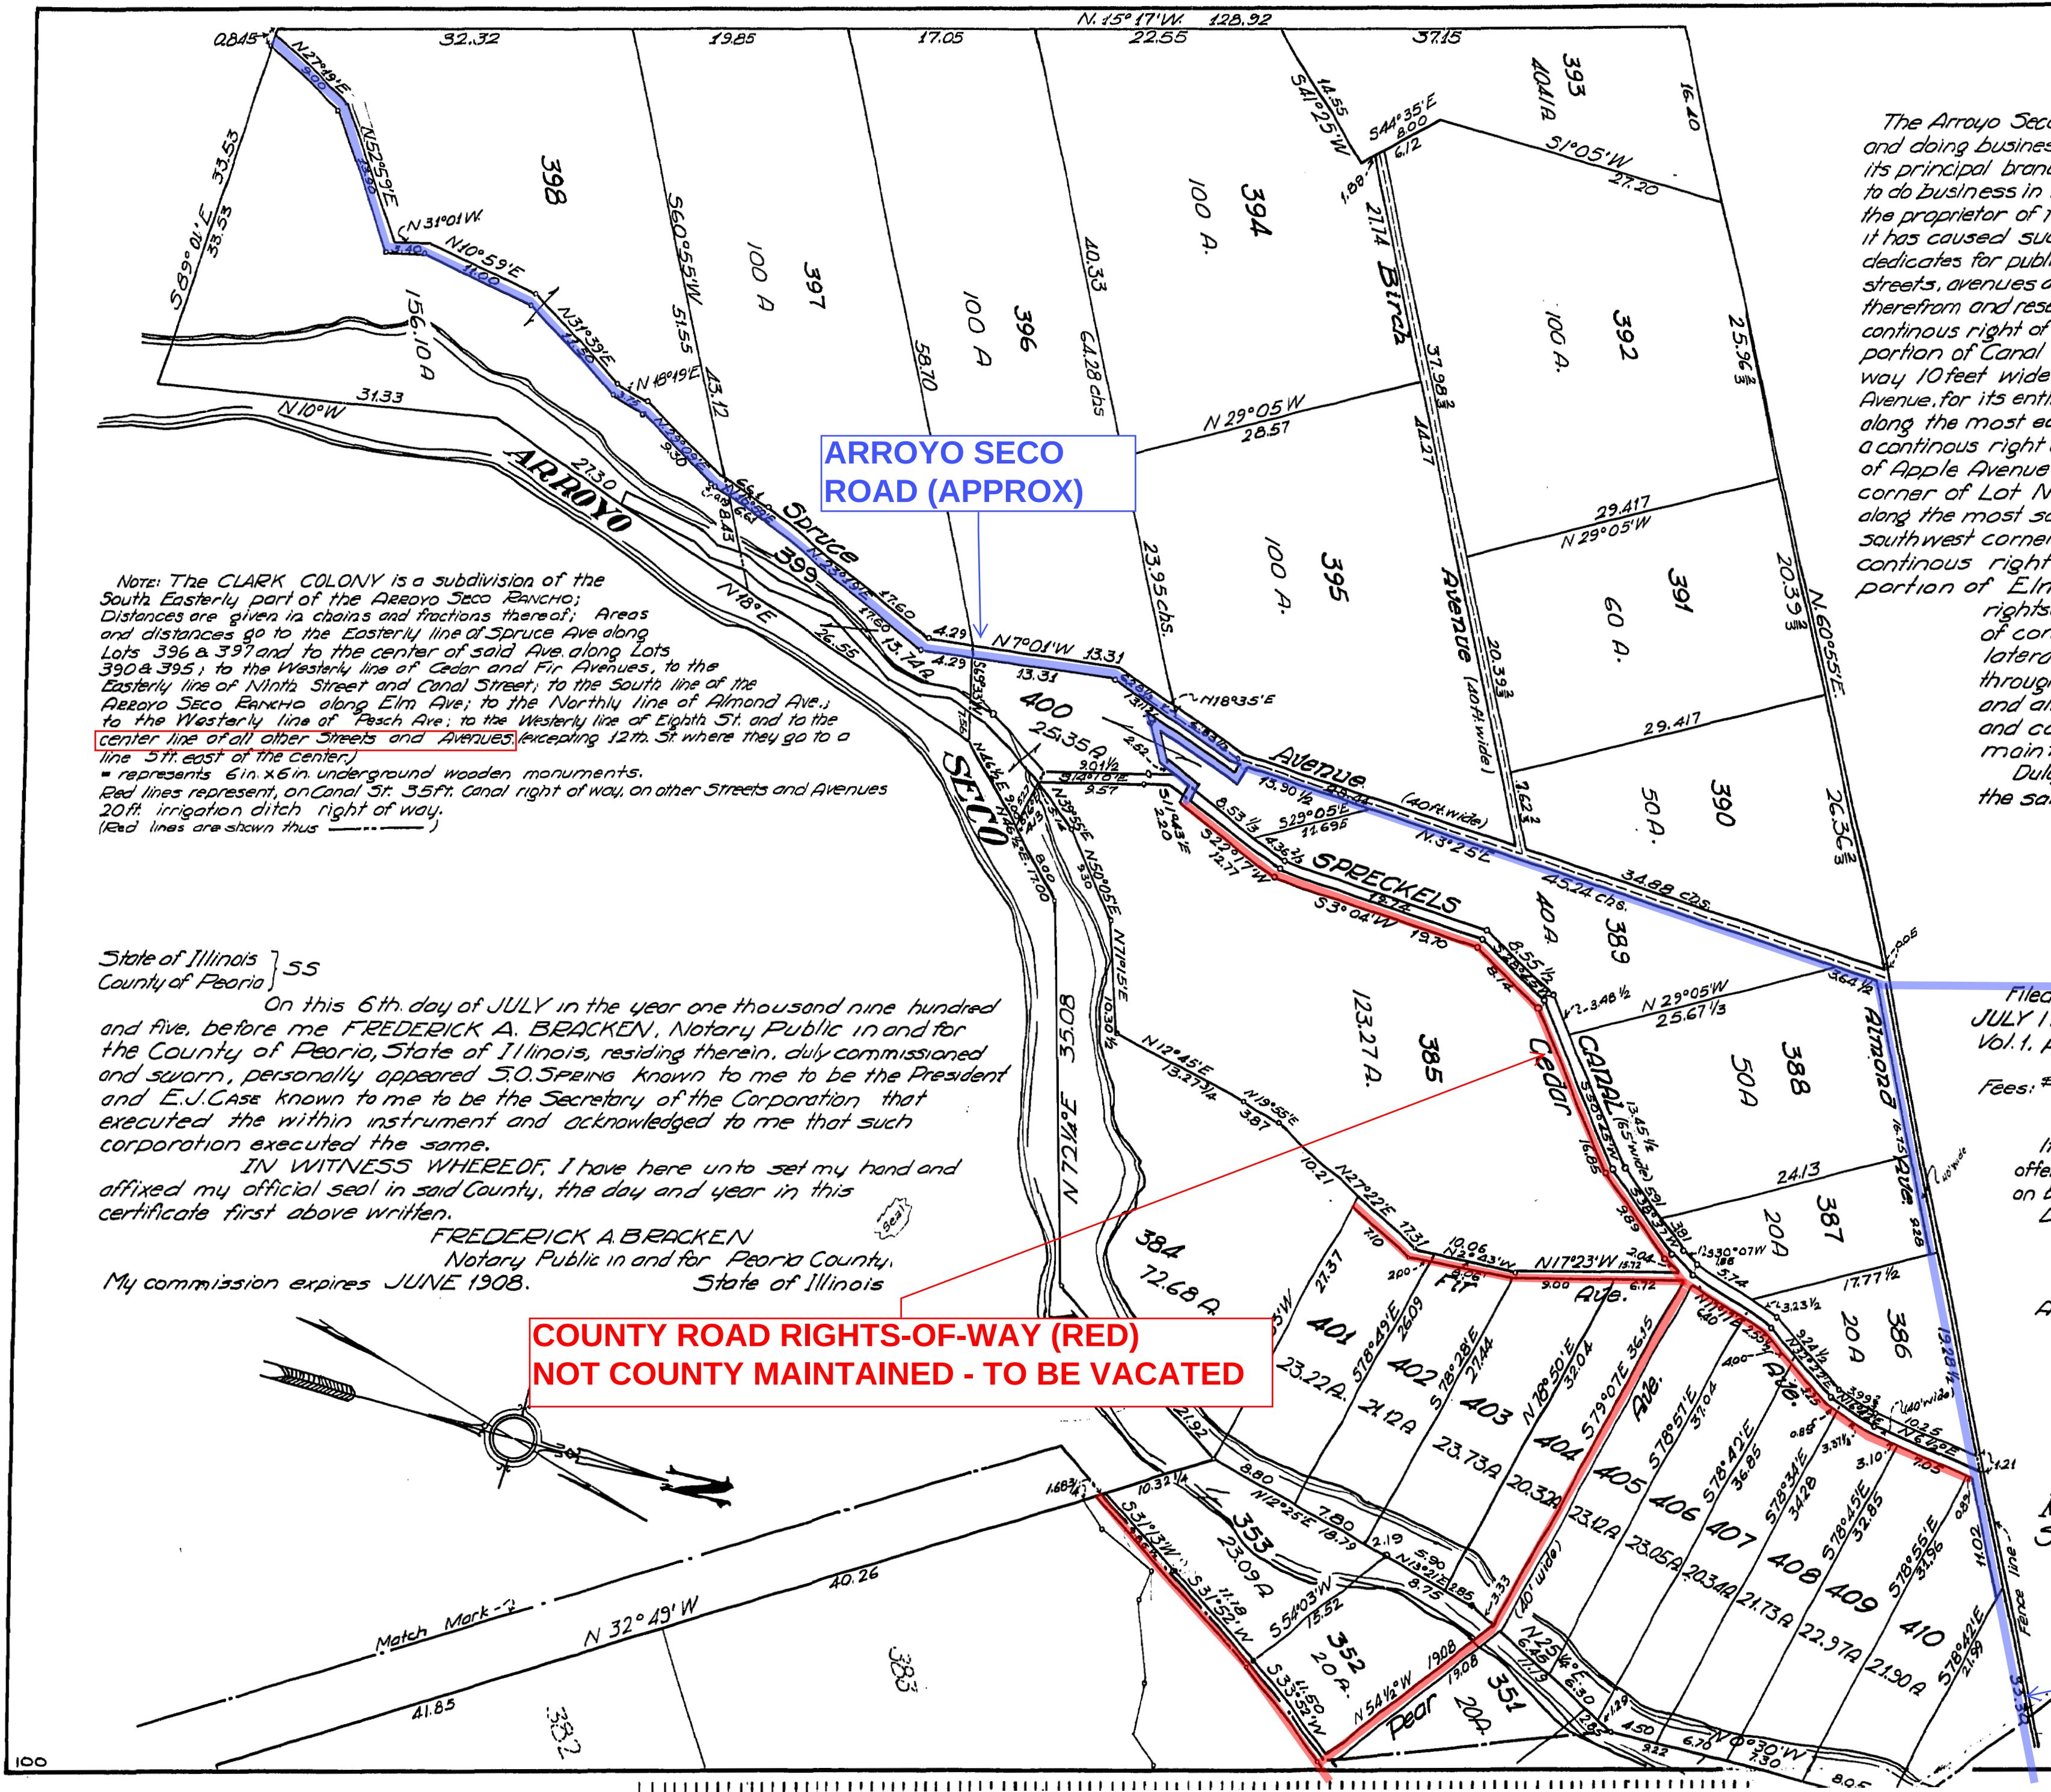

ATTACHMENT D
2 OF 2

02862

Vol. 1, Pg. 64.

THORNE ROAD

MAP
CLARK COLONY
MONTEREY COUNTY, CALIF.
SURVEYED BY H.B. FISHER SURV. & CL. 1905
Scale 1 in. = 10 chains

Copied from original map filed in
Vol. 1, pg. 64, of Cities and Towns

Subject roads of the
Petition (green)

PEACH AVENUE EXTENSION
V 182 DEEDS 158

COUNTY ROAD RIGHTS-OF-WAY (RED)
NOT COUNTY MAINTAINED - TO BE VACATED

COUNTY MAINTAINED
ROADS TO BE VACATED

CITY SPHERE OF
INFLUENCE

CITY OF GREENFIELD

ELM AVENUE

